


PIT STATUS EVALUATION FORM

Facility ID: 115169

Pit Name: EVERITT 41-19 2

☐ Duplicate Record(s) Pit #

115170

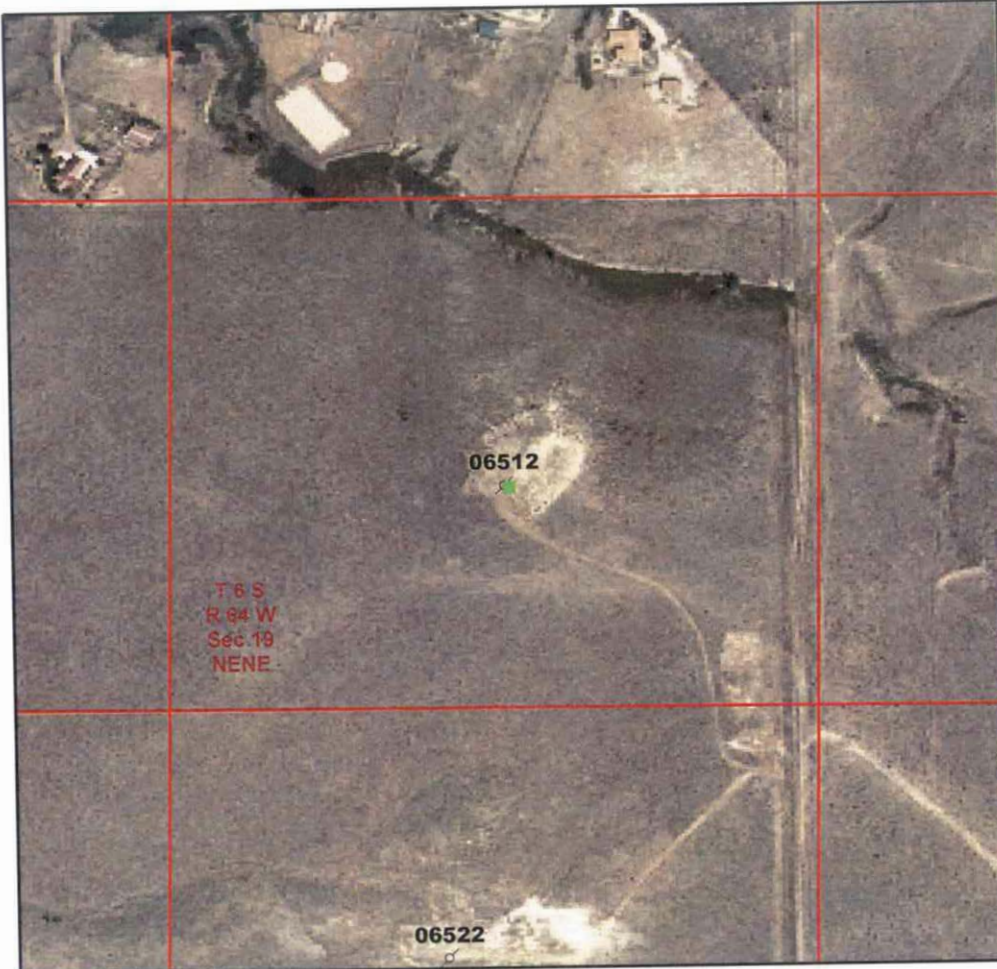

Legend

- ☒ Database Pit Location
- ☒ Producing Well
- ☒ Shut In Well
- ☒ Temp Aban Well
- ☒ Abandoned Well
- ☒ Dry & Aban Well
- ☒ Injection Well
- ☒ Other Well Status



1:6,000
0 250 500 750 Feet

Image Source:
USDA National Agricultural Imagery
Program (NAIP), 2006

S.S. PAPADOPULOS & ASSOCIATES, INC.

COGCC Database Information

Status: NR Owner: ARLIAN, INC.

T: 6S R: 64W Sec: 19 QQ: NENE 6th Meridian

Latitude: 39.519036 Longitude: -104.590529 NAD83

County: Elbert, CO

County Code: 039

Pit Status Evaluation

☐ Active

☐ Form 15: Pit Permit _____ Assoc. Well Seq No(s) _____

☐ Other documentation _____

☐ Aerial photo verification

☐ Closed

☐ Form 27: Remediation Workplan _____

☐ Form 4: Sundry Notice _____

☐ Rule 903a.(2)B

☒ Evidence pit(s) existed, no closure docs & well not PR, AC or SI

Well API Seq #(s) 06512 PA (5-14-1999) # 500141563

☒ Other documentation LIF # 581364 (10-15-1985)

☐ Abandoned

☐ Possible un-reclaimed pit(s) or adverse conditions, no closure docs

☐ Site Visit

☐ No Site Visit

☐ Add'l Review

☐ Unknown

Notes: Pit Status & documentation under Facility ID# 115170
LIF (1985) "common to [EVERITT 42-19] #JA"