





00101180

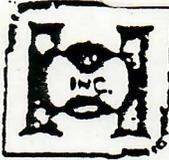

Holloway & Holloway, Inc.
P.O. Box 3331
Greeley, CO 80633
(303) 867-3715
(303) 352-5852

R67W

NE cor. re-bar
in roadway

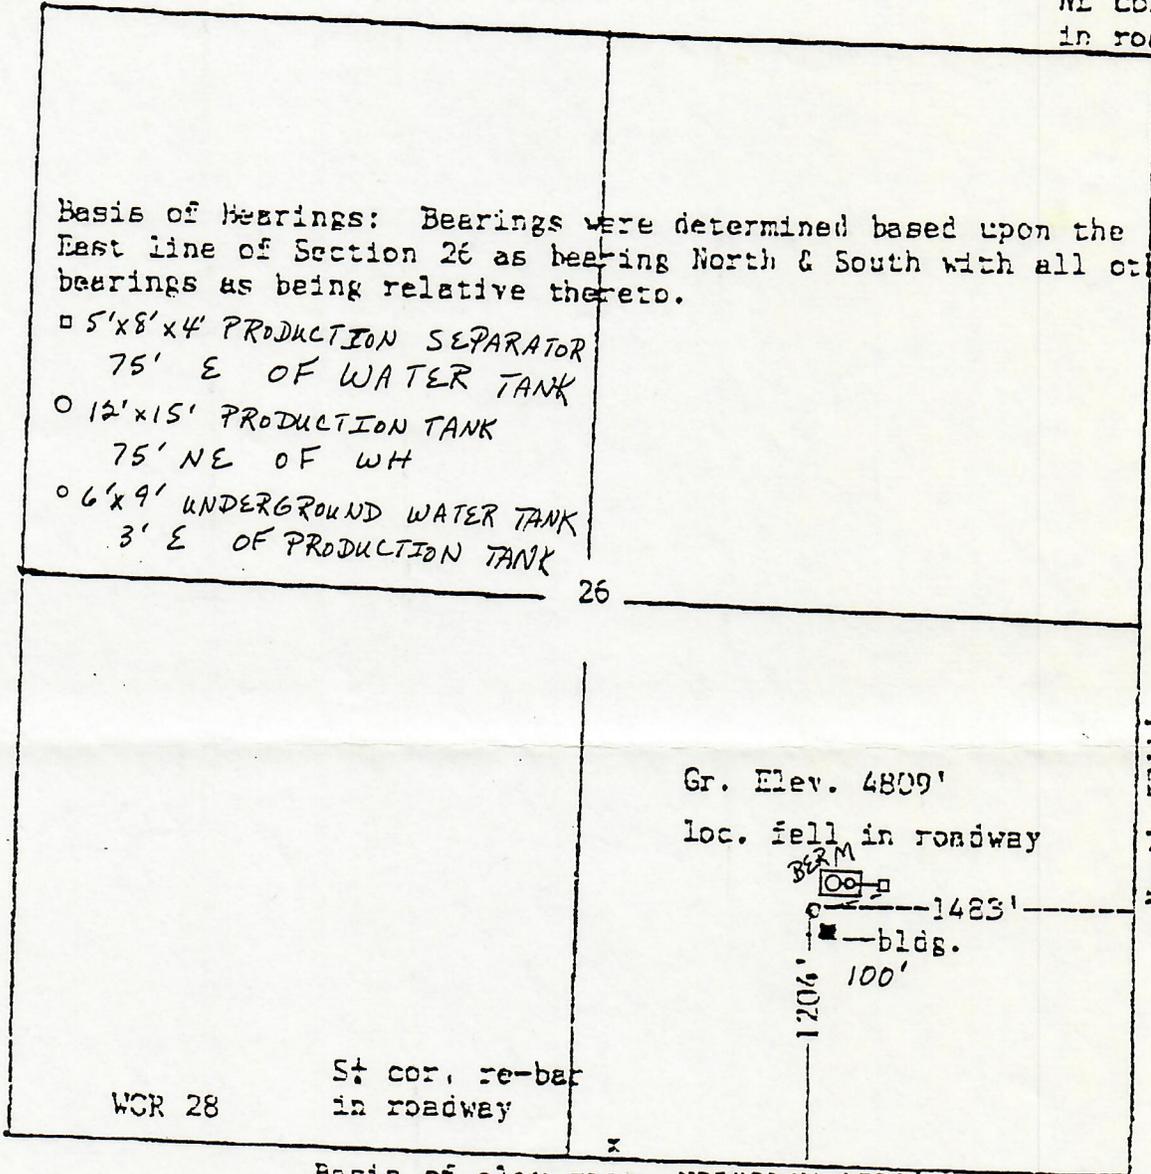

Basis of elev spot N88°21'W 2570'
elev. 4814'

Scale --- 1" = 1000'

In accordance with a request from Basin Operating Company
the Undersigned has determined the location of the Magness 34-26 well
to be 1204'FSL & 1483'FEL at right angles as co-ordinates
Section 26 Township 3N Range 67W of the 6th principal Meridian
Weld County, Colorado.

110