

Inspection Photos
Location Name: Aristocrat Angus Ranches
Facility ID: 117948



Photo 1 – 1999 Google Earth aerial imagery. Star indicates location of permitted Pit #117948.

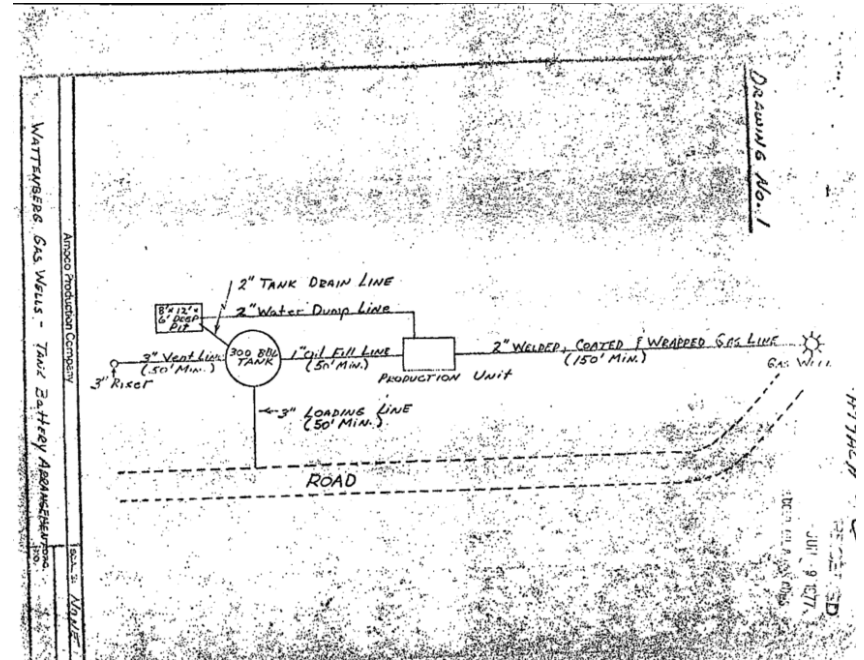


Photo 2 – Sketch from pit permit (Doc #1490765). Presumed north is down.

Inspection Photos
Location Name: Aristocrat Angus Ranches
Facility ID: 117948



Photo 3 – Tank battery equipment has not been removed. Third party meter shed is still in place. Reclamation of footprint not achieved.



Photo 2 – Remediation 4348 monitoring wells and associated equipment.