


# PIT STATUS EVALUATION FORM

Facility ID: 115191

Pit Name: NOVA 20-10

☐ Duplicate Record(s) Pit #

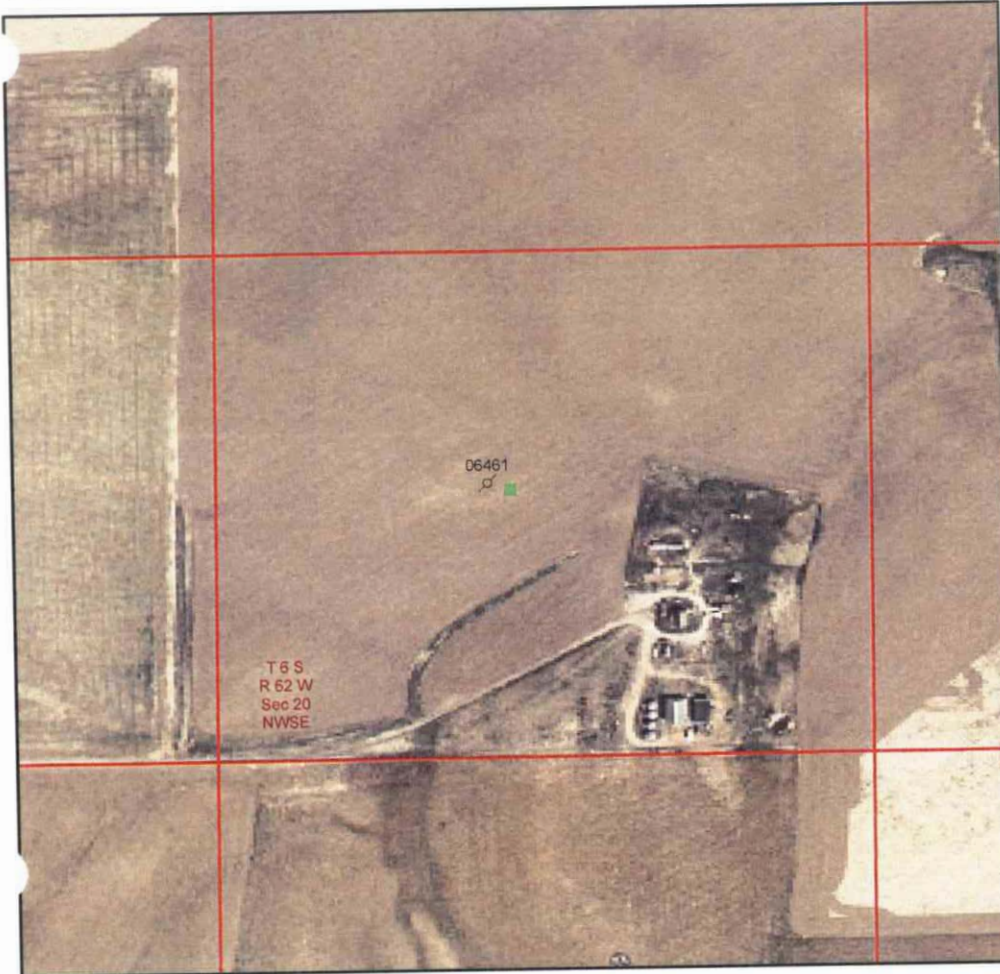

## Legend

- ☒ Database Pit Location
- ☐ Producing Well
- ☐ Shut In Well
- ☐ Temp Aban Well
- ☐ Abandoned Well
- ☐ Dry & Aban Well
- ☐ Injection Well
- ☐ Other Well Status



1:6,000  
0 250 500 750 Feet

Image Source:  
USDA National Agricultural Imagery  
Program (NAIP), 2006

 S.S. PAPADOPOULOS & ASSOCIATES, INC.

## COGCC Database Information

Status: NR Owner: ROCK OIL CORP  
T: 6S R: 62W Sec: 20 QQ: NWSE 6th Meridian  
Latitude: 39.511538 Longitude: -104.355271 NAD83

County: Elbert, CO  
County Code: 039

## Pit Status Evaluation

- ☐ Active ☐ Form 15: Pit Permit \_\_\_\_\_ Assoc. Well Seq No(s) \_\_\_\_\_  
☐ Other documentation \_\_\_\_\_  
☐ Aerial photo verification \_\_\_\_\_
- ☒ Closed ☐ Form 27: Remediation Workplan \_\_\_\_\_  
☐ Form 4: Sundry Notice \_\_\_\_\_  
☐ Rule 903a.(2)B \_\_\_\_\_  
☒ Evidence pit(s) existed, no closure docs & well not PR, AC or SI  
Well API Seq #(s) 06461 PA (3-8-1997)  
☒ Other documentation FIR#429595 (6-26-1997)
- ☐ Abandoned ☐ Possible un-reclaimed pit(s) or adverse conditions, no closure docs ☐ Site Visit  
☐ No Site Visit  
☐ Add'l Review
- ☐ Unknown

Notes: LIF(7-3-1985) 15'x20' unlined, unfenced, 100% ocld.  
FIR(1997) "well plugged and location restored. plowed field"