


CLEAR CREEK RESOURCE PARTNERS

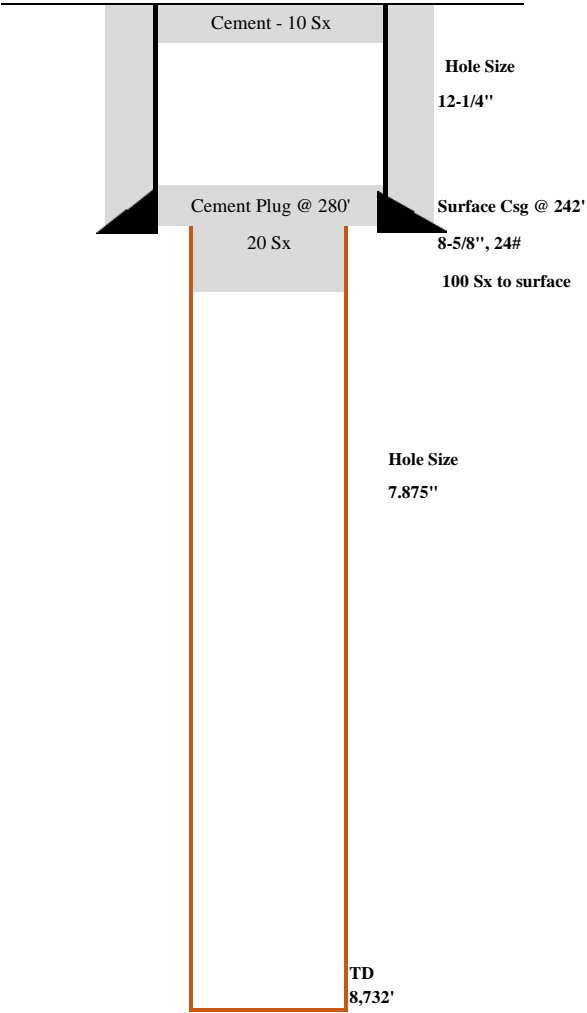

Well/Facility:	Kiesselbach #1	Well Status:	Current
Operator:	Davis Oil Company	Formation:	Dakota
Field:	Wildcat	Prod Int:	
County:	Weld	API #	05-123-10560
State:	CO	GR/KB	5,445'
Spud:	3/8/1982	TD:	8,732'
Comp. Date:	3/19/1982	PBTD:	
1st Prod:		Lat:	40.952839
Surface Loc:		Long:	-104.511698
Sec-Twn-Rge	SWNE Sec. 2, 11N, 64W		
Comments:	Existing Wellbore Layout		

Formation Tops	
MD	
1196	Fox Hills
1446	Pierre
4492	Teapot
4626	Parkman
5168	Sussex
5710	Shannon
7574	Sharon Springs
7615	Niobrara
7901	Codell
7919	Carlisle