


(067-40056)

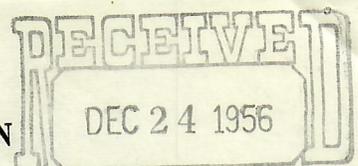

OIL AND GAS CONSERVATION COMMISSION OF THE STATE OF COLORADO

OIL & GAS CONSERVATION COMMISSION

NOTICE OF INTENTION TO DRILL




INSTRUCTIONS:

A notice of intention to drill a well shall be filed in duplicate on all Federal and Patented lands, and in triplicate on all State lands. Do not begin operations until approved copy has been received. It is mandatory that the proposed location comply with all rules and regulations of the Commission. Locate well on section grid in proper location, and indicate extent of lease. Unless operations are commenced within 180 days after the date of approval hereof, this approval to drill will become null and void.

Name of Operator General Petroleum Corporation Phone No. DA 2-5581
Address 53 East Fourth South Street City Salt Lake City State Utah

How is liability secured: Well Bond (Attached) []; Blanket Bond []; Waiver [X] (Check one)

Lease Name Tribal 4 (Indian Land)
Well No. Tribal 4 #67X-23
Field Name Wildcat [X]
County La Plata

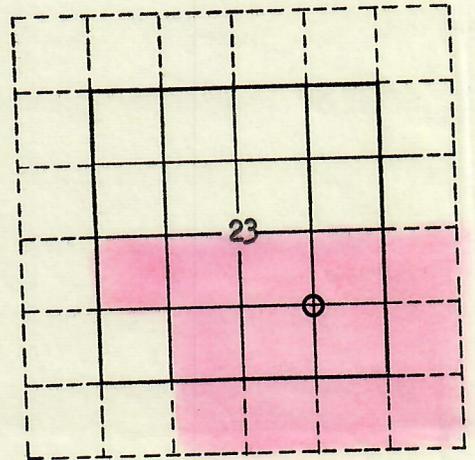

Location C of SE/4 (quarter quarter) Section 23 Township 34 N Range 10 W Meridian N.M.B.&M.
1320 feet from S Section line and 1320 feet from E Section Line

The well is located on: Patented land [] State land [] Federal land [X] (Indian Land)

The well is located within a spaced area: Yes [] No [X]

Distance from proposed location to nearest property or lease line 1320 feet.
Distance from proposed location to nearest drilling unit line None established feet.

Objectives: Mesaverde Formation Depth 5000' Estimate; Formation Depth Estimate

Proposed length of surface casing approx. 300' feet. of 11-3/4" casing.

REMARKS:

Table with columns for initials: AJJ, DVR, FJK, VRS, HMM, AH, JJD, FILE



I/We hereby swear (or affirm) that the statements herein made are a full and correct report.

APPROVED: Date DEC 26 1956

Company General Petroleum Corp. Date December 20, 1956
Address Salt Lake City, Utah Phone No. DA 2-5581

Signature of Director

By A.L. Hair Signature Title Div. Supt.