


PIT STATUS EVALUATION FORM

Facility ID: 115089

Pit Name: WHITEHEAD 4-11

Duplicate Record(s) Pit #

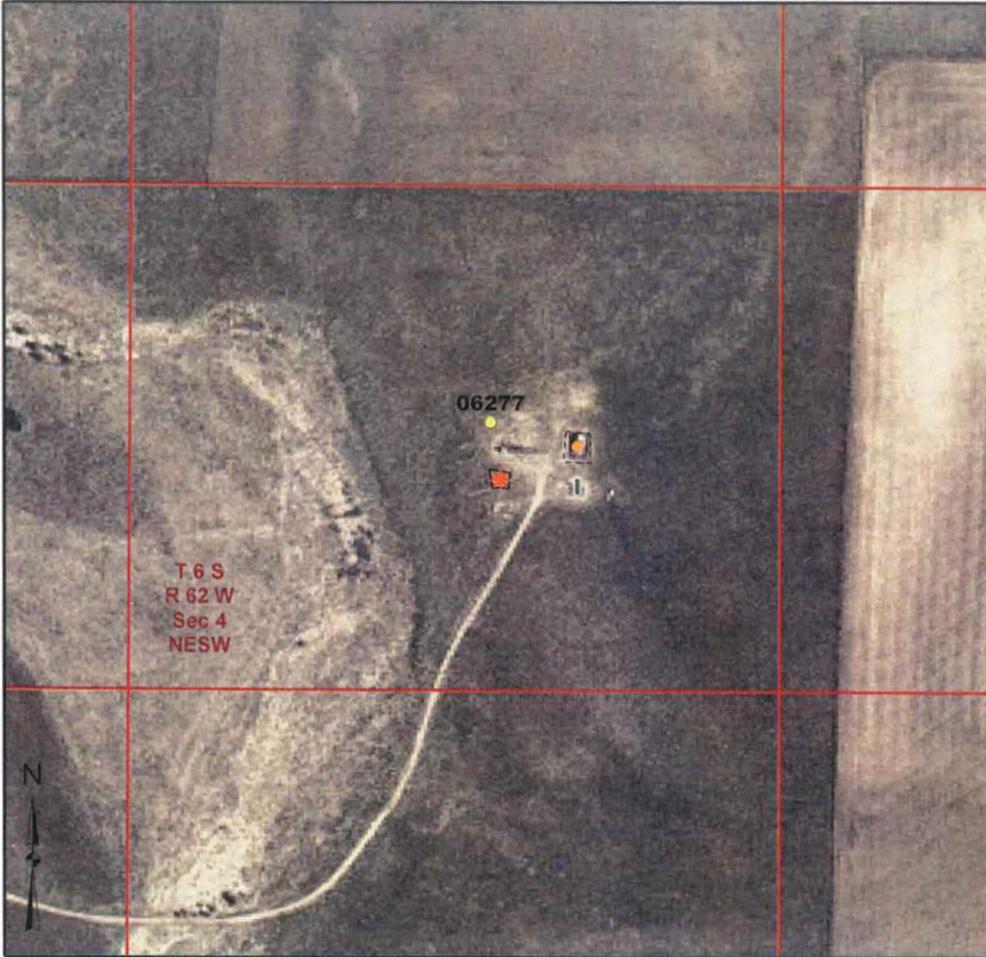

Legend

- Producing or Shut In Well
- ⚡ Temp Aban Well
- ⚡ Abandoned Well
- ⊙ Dry & Aban Well
- ⊙ Earthen Pit
- Culvert
- * Backfilled Pit(s)
- Vault
- Fiberglass Tank
- Steel Tank(s)
- ⊥ Separator
- Wellhead
- Earthen Pit Extent
- Area of Disturbance
- Backfilled Pit Extent
- - - Tank Fence

1:6,000

0 250 500 750 Feet

Image Source:
USDA National Agricultural Imagery Program (NAIP), 2006

S.S. PAPADOPULOS & ASSOCIATES, INC.

COGCC Database Information

Status: NR Owner: RENEGADE OIL & GAS COMPANY LLC
T: 6S R: 62W Sec: 4 QQ: NESW 6th Meridian
Latitude: 39.554579 Longitude: -104.340356 NAD83

County: Elbert, CO
County Code: 039

Pit Status Evaluation

- Active**
- Form 15: Pit Permit (1983) existing Assoc. Well Seq No(s) 06277 PR (3-16-78)
 - Other documentation FIR# 200124015 (6-2007)
 - Aerial photo verification
- Closed**
- Form 27: Remediation Workplan _____
 - Form 4: Sundry Notice _____
 - Rule 903a.(2)B
 - Evidence pit(s) existed, no closure docs & well not PR, AC or SI
Well API Seq #(s) _____
 - Other documentation _____
- Abandoned** Possible un-reclaimed pit(s) or adverse conditions, no closure docs
- Unknown**
- Site Visit
 No Site Visit
 Add'l Review

Notes: FIR (5-1996) indicates earthen overflow pit & buried metal skim tank
FIR (6-15-2007) indicates 3,200 BBL uprights #200124015
FIELD VISIT 6-4-2008 : PIT BACKFILLED. SITE CLEAN



Photo 1. Whitehead 4-11 wellhead and lease sign



Photo 2. Looking east at three 300 BBL tanks and separator



Photo 3. Looking north at former location of pit in foreground of wellhead