


**PIT STATUS EVALUATION FORM**

Facility ID: 115096  
 Pit Name: WHITEHEAD 18-4

Duplicate Record(s) Pit #

119945

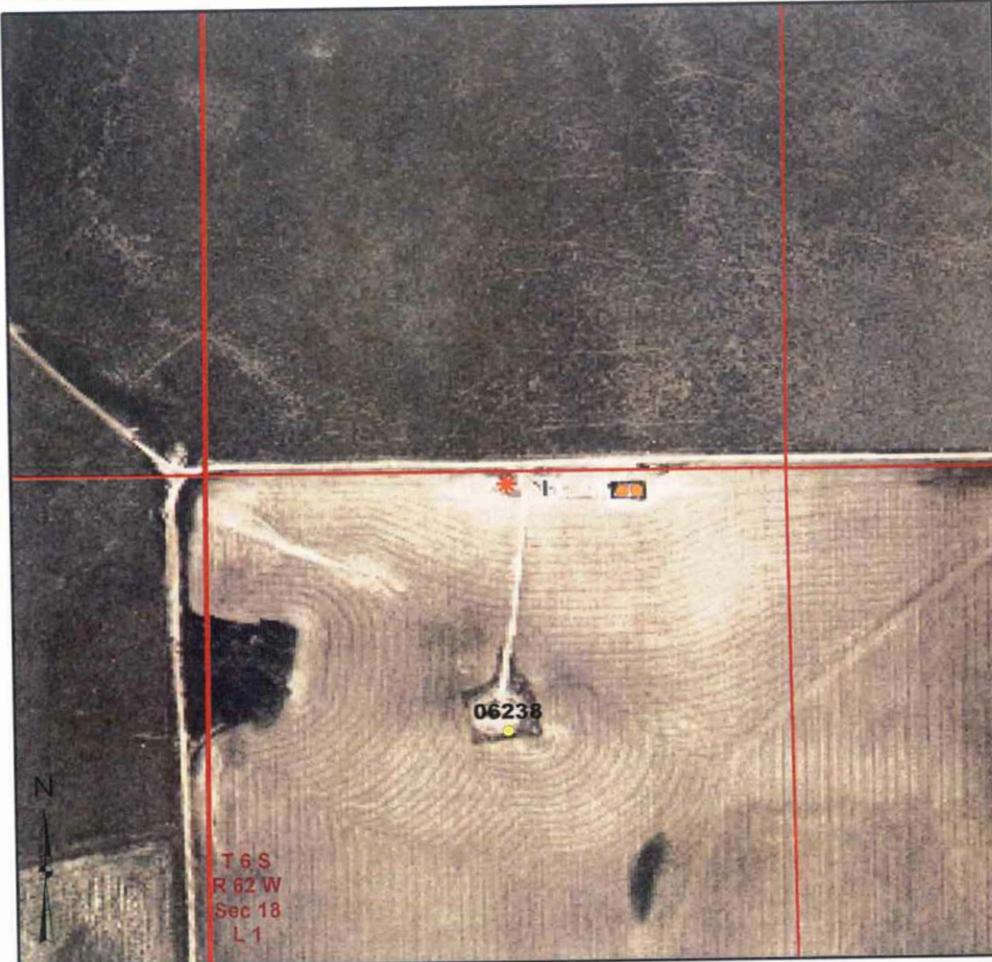

**Legend**

- Producing or Shut In Well
- ⚡ Temp Aban Well
- ⚡ Abandoned Well
- ⚡ Dry & Aban Well
- ⊙ Earthen Pit
- Culvert
- \* Backfilled Pit(s)
- Vault
- Fiberglass Tank
- Steel Tank(s)
- | Separator
- Wellhead
- Earthen Pit Extent
- Area of Disturbance
- Backfilled Pit Extent
- - - Tank Fence



Image Source:  
 USDA National Agricultural Imagery  
 Program (NAIP), 2006

S.S. PAPANOPULOS & ASSOCIATES, INC.

**COGCC Database Information**

Status: NR Owner: RENEGADE OIL & GAS COMPANY LLC  
 T: 6S R: 62W Sec: 18 QQ: NWNW 6th Meridian  
 Latitude: 39.534871 Longitude: -104.382768 NAD83

County: Elbert, CO  
 County Code: 039

**Pit Status Evaluation**

- Active  Form 15: Pit Permit #690672 #847317 (1983) & existing Assoc. Well Seq No(s) 06238 PR(2-04)
- Other documentation \_\_\_\_\_
- Aerial photo verification \_\_\_\_\_
- Closed  Form 27: Remediation Workplan \_\_\_\_\_
- Form 4: Sundry Notice \_\_\_\_\_
- Rule 903a.(2)B \_\_\_\_\_
- Evidence pit(s) existed, no closure docs & well not PR, AC or SI
- Well API Seq #(s) \_\_\_\_\_
- Other documentation \_\_\_\_\_
- Abandoned  Possible un-reclaimed pit(s) or adverse conditions, no closure docs
- Unknown  Site Visit
- No Site Visit
- Add'l Review

Notes: LIF #690673(8-87) 30'x30' wire covered, unlined pit, Pictures (1999)  
FIELD VISIT 6-4-2008: PIT BACKFILLED  
found covered steel tank for water storage



Photo 1. Whitehead 18-4 tank battery lease sign



Photo 2. Battery tank and covered steel water tank



**Photo 3. Looking east at former pit site beyond vertical separator**



**Photo 4. Backfilled pit site**



**Photo 5. Looking east at backfilled pit site in foreground**