


Well Completion Diagram

API Well No: 05-061-06713-00-							
Owner:	SPRING* THOMAS L			Well Name:	WARNE TEMPLIN		
County:	KIOWA	Field:	MCCLAVE	Pool:			
Coordinates: X	1200 FEL	Y	1200 FSL	Sec:	29	Twp:	20S Rng: 48W

Note: Changes to the drawing do not effect the database

Current

Bore Diameters (in.)

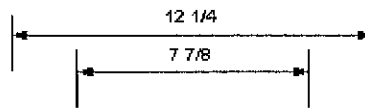

Cement Top: 0' mthd:U

Cement Top: 0' mthd:U

8 5/8" SURF 300'

Cement up 205 SX

*DV tool @
2972' w/
450 SX*

*Cement
4290 SX*

2 3/8" Packer 4,740'

2 3/8" Tubing 4,729'

Total Vertical Depth 4,760'

4 1/2" 1ST 4,729'

Perfs. 4,729-4,760'