

## Colorado Interstate Gas

**LEASE:** Young #40  
**FIELD:** Young  
**COUNTY:** Morgan  
**STATE:** Colorado  
**LOCATION:** 2 4N 58W  
**API #:** 05-087-08078-00  
**SPUD DATE:** 09/27/97  
**Rev. Date** 04/11/19 - APT

ELEVATION: 4528' KB: 0


TD: 6006' GL PBTD: 5982' GL

Size	ID
8-5/8	8.097
5-1/2	4.95
2-3/8	1.995
Seating Nipple	1.78

Perfs 5868' – 5874' GL w/ 4 SPF

PBTD @ 5982' GL

TD 7-7/8" hole @ 6005' GL

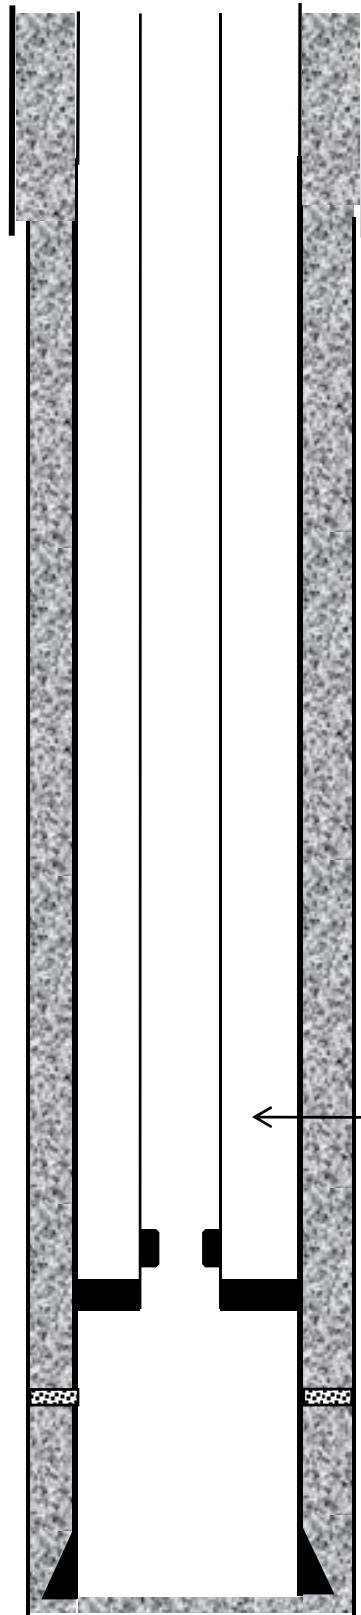

8 jts, 8-5/8", 24#, J55, 8R ST&C csg set at 313 GL

Cemented surface w/ 200 sks  
Standard cmt. Cmt Circ.

TD 12-1/4" surface hole at 328' GL

186 jts & 1 ea. 10' sub, 2-3/8", 4.7#, J55, 8R, EUE tbg, Sub below 1<sup>st</sup> jt.

Seating Nipple at 5835' GL

Baker LOK Set packer at 5839' GL w/  
8,000# compression

Cmt'd w/ 900 sks HLC followed by 250 sks  
50/50 Poz. Cmt Circ.

138 jts, 5-1/2", 15.5#, K55, 8R, LT&C casing  
set at 6002' GL