


# PIT STATUS EVALUATION FORM

Facility ID: 115099

Pit Name: CHAMPLIN 416 AMOCO "C" 1

☐ Duplicate Record(s) Pit #

113201

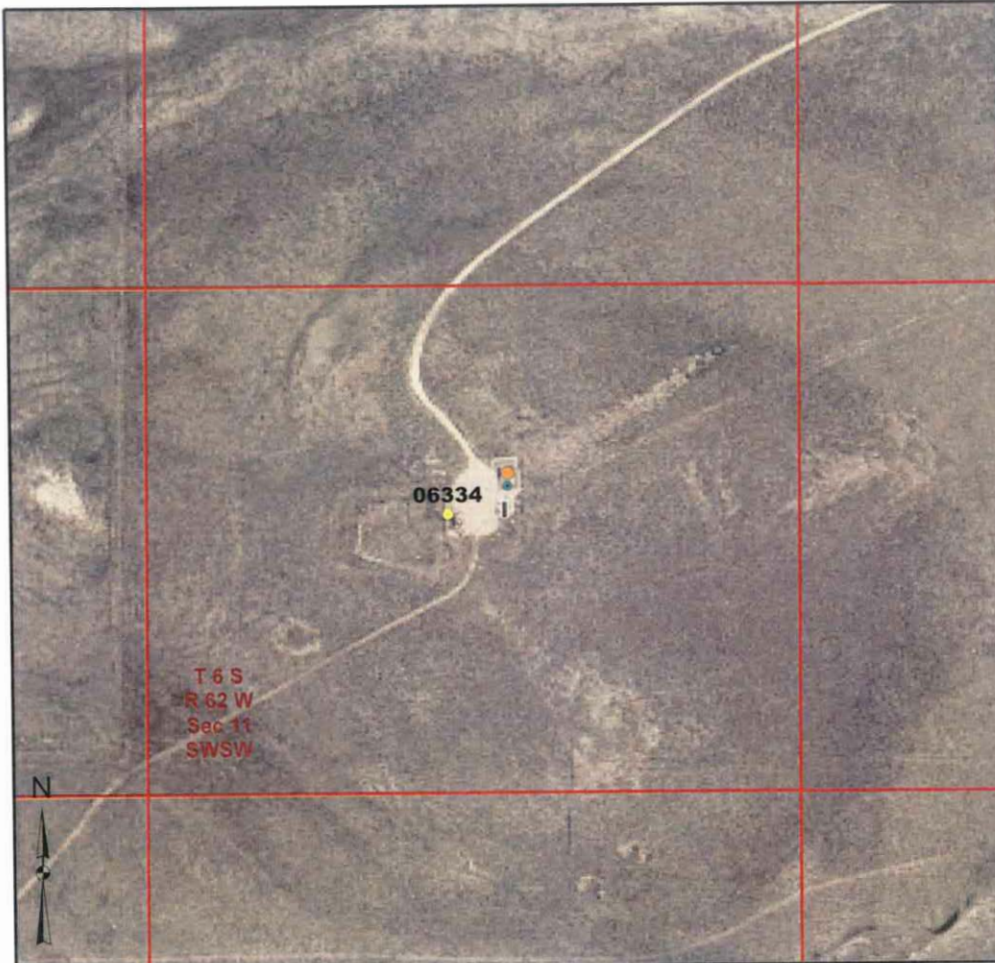

## Legend

- Producing or Shut In Well
- Temp Aban Well
- Abandoned Well
- Dry & Aban Well
- Earthen Pit
- Culvert
- Backfilled Pit(s)
- Vault
- Fiberglass Tank
- Steel Tank(s)
- Separator
- Wellhead
- Earthen Pit Extent
- Area of Disturbance
- Backfilled Pit Extent
- Tank Fence

1:6,000

0 250 500 750 Feet

Image Source:  
USDA National Agricultural Imagery  
Program (NAIP), 2006

S.S. PAPADOPULOS & ASSOCIATES, INC.

## COGCC Database Information

Status: NR Owner: RENEGADE OIL & GAS COMPANY LLC  
T: 6S R: 62W Sec: 11 QQ: SWSW 6th Meridian  
Latitude: 39.537146 Longitude: -104.307793 NAD83

County: Elbert, CO  
County Code: 039

## Pit Status Evaluation

- ☐ Active ☐ Form 15: Pit Permit (1980) new Assoc. Well Seq No(s) 06334 (12-1996) PR  
☐ Other documentation \_\_\_\_\_  
☐ Aerial photo verification \_\_\_\_\_
- ☒ Closed ☐ Form 27: Remediation Workplan \_\_\_\_\_  
☐ Form 4: Sundry Notice #690634 (6-22-1985)  
☐ Rule 903a.(2)B \_\_\_\_\_  
☐ Evidence pit(s) existed, no closure docs & well not PR, AC or SI  
Well API Seq #(s) \_\_\_\_\_  
☐ Other documentation \_\_\_\_\_
- ☐ Abandoned ☐ Possible un-reclaimed pit(s) or adverse conditions, no closure docs ☒ Site Visit  
☐ Unknown ☐ No Site Visit  
☐ Add'l Review

Notes: (1985) oil cleaned from pit 150' x 150', FIR (4-2-08) no mention of pit  
WSIF (1998) 1500 gal. plastic H<sub>2</sub>O tank  
FIELD VISIT 6-4-2008: NO PIT FOUND. SITE CLEAN & LEVEL. NO VEGETATION  
DISTURBANCE NEAR WELL PAD.



Photo 1. Covered fiberglass water tank



Photo 2. Champlin 416 Amoco "C" 1 wellhead





**Photo 3. Horizontal separator**



**Photo 4. Looking north from the southwest corner of the wellpad**



**Photo 5. Looking northeast from the southwest corner of well pad.  
The former pit site may have been at the southeast corner of the well pad (right in photo).**