


PIT STATUS EVALUATION FORM

Facility ID: 115112

Pit Name: WHITEHEAD 31-20A

☐ Duplicate Record(s) Pit #

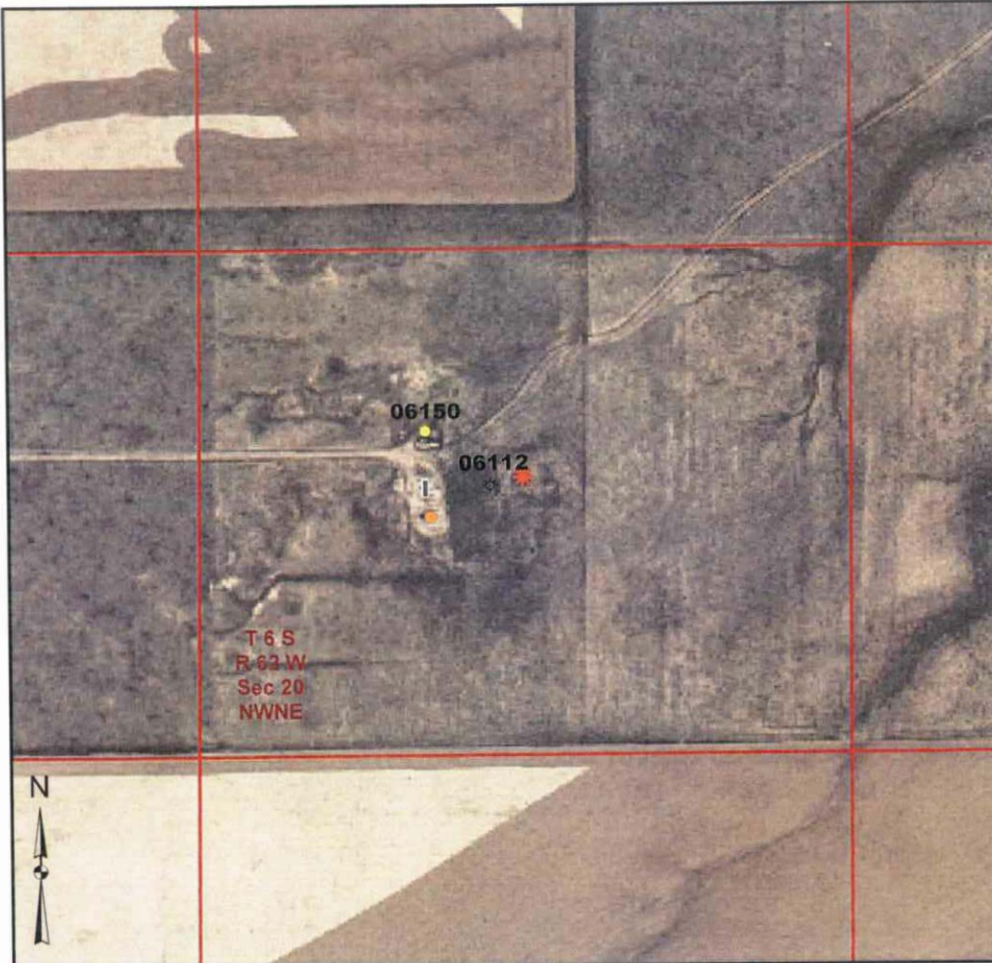

Legend

- Producing or Shut In Well
- ⚡ Temp Aban Well
- ⚡ Abandoned Well
- ⚡ Dry & Aban Well
- Earthen Pit
- Culvert
- ✱ Backfilled Pit(s)
- Vault
- Fiberglass Tank
- Steel Tank(s)
- | Separator
- Wellhead
- Earthen Pit Extent
- Area of Disturbance
- Backfilled Pit Extent
- Tank Fence

1:6,000

0 250 500 750 Feet

Image Source:
USDA National Agricultural Imagery
Program (NAIP), 2006

S.S. PAPADOPULOS & ASSOCIATES, INC.

COGCC Database Information

Status: NR Owner: SAXON OIL CO
T: 6S R: 62W Sec: 20 QQ: NWNE 6th Meridian
Latitude: 39.518777 Longitude: -104.355111 NAD83

County: Elbert, CO
County Code: 039

Pit Status Evaluation

☐ Active

☐ Form 15: Pit Permit (1976) existing Assoc. Well Seq No(s) 06150 (9-4-92) PR
☐ Other documentation NOAV (9-13-07)
☐ Aerial photo verification

☒ Closed

*horizontal
flat tank*

☐ Form 27: Remediation Workplan _____
☐ Form 4: Sundry Notice _____
☐ Rule 903a.(2)B
☐ Evidence pit(s) existed, no closure docs & well not PR, AC or SI
Well API Seq #(s) _____
☐ Other documentation FIR (4-1-08) #200130071 ; FIR (11-30-07)

☐ Abandoned

☐ Possible un-reclaimed pit(s) or adverse conditions, no closure docs

☒ Site Visit
☐ No Site Visit
☐ Add'l Review

☐ Unknown

Notes: FIR (2008) "covered flat tank above ground"

FIELD VISIT 6-4-2008: PIT BACKFILLED & SITE CLEAN.

Facility ID 115112
Well API 05-039-06150
Well API 05-039-06112

Whitehead 31-20A
Whitehead 31-20A
Whitehead 31-20

June 4, 2008



**Photo 1. Looking east at marker for Whitehead 31-20 plugged and abandoned well;
former pit site is beyond marker.**

Facility ID 115112
Well API 05-039-06150
Well API 05-039-06112

Whitehead 31-20A
Whitehead 31-20A
Whitehead 31-20

June 4, 2008



Photo 2. Looking west at former pit site in foreground and Whitehead 31-20A wellhead and equipment