


PIT STATUS EVALUATION FORM

Facility ID: 115120

Pit Name: CHAMPLIN 548 "A" 1 & 2

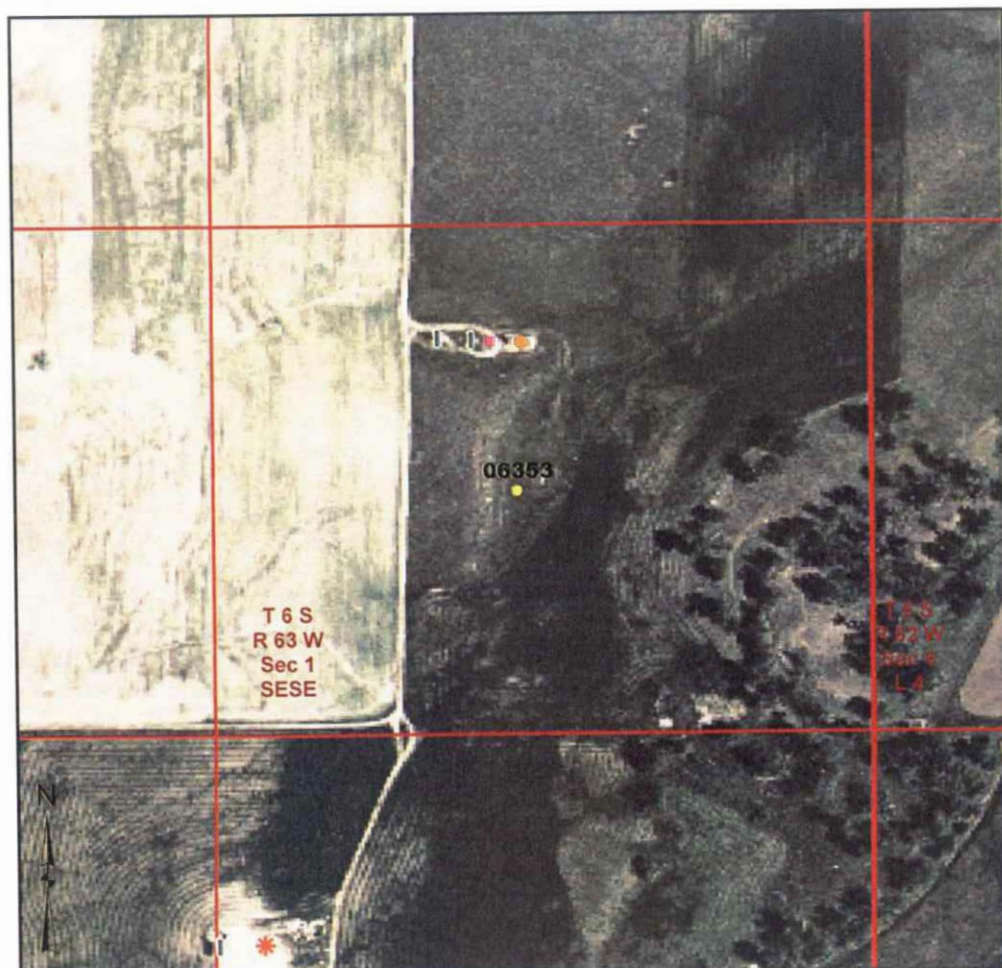

Legend

- Producing or Shut In Well
- ⊗ Temp Aban Well
- ⊗ Abandoned Well
- ⊗ Dry & Aban Well
- ⊗ Earthen Pit
- Culvert
- ✱ Backfilled Pit(s)
- Vault
- Fiberglass Tank
- Steel Tank(s)
- | Separator
- Wellhead
- Earthen Pit Extent
- Area of Disturbance
- Backfilled Pit Extent
- Tank Fence

1:6,000

0 250 500 750 Feet

Image Source:
USDA National Agricultural Imagery
Program (NAIP), 2006

S.S. PAPADOPULOS & ASSOCIATES, INC.

COGCC Database Information

Status: NR Owner: SMITH ENERGY CORP
T: 6S R: 63W Sec: 1 QQ: SESE 6th Meridian
Latitude: 39.551197 Longitude: -104.387343 NAD83

County: Elbert, CO
County Code: 039

Pit Status Evaluation

☐ Active

☐ Form 15: Pit Permit NA Assoc. Well Seq No(s) 06353 #1
☐ Other documentation 06406 #2
☐ Aerial photo verification

☒ Closed

☐ Form 27: Remediation Workplan _____
☐ Form 4: Sundry Notice _____
☐ Rule 903a.(2)B _____
☐ Evidence pit(s) existed, no closure docs & well not PR, AC or SI
Well API Seq #(s) FIR(1995); FIR(2004) #1230126
☐ Other documentation _____

☐ Abandoned☐ Possible un-reclaimed pit(s) or adverse conditions, no closure docs

☒ Site Visit
☐ No Site Visit
☐ Add'l Review

☐ Unknown

Notes:

Common use for Champlin 548 #1 & #2
FIR (2004) "Vault open"

FIELD VISIT 6-4-2008: Concrete Vault. No pits at either well site

Facility ID 115120
Well API 05-039-06353
Well API 05-039-06406

Champlin 548 "A" 1 & 2
Champlin Amoco 548 A 1
Champlin Amoco 548 A 2

June 4, 2008



Photo 1. Champlin 548 1 & 2 battery tank sign



Photo 2. Buried concrete vault

Facility ID 115120
Well API 05-039-06353
Well API 05-039-06406

Champlin 548 "A" 1 & 2
Champlin Amoco 548 A 1
Champlin Amoco 548 A 2

June 4, 2008



Photo 3. Buried concrete vault and two separators to the west