


Well Name: SINJIN E36-10

VERTICAL, ORIGINAL HOLE, 4/11/2019 1:06:40 PM

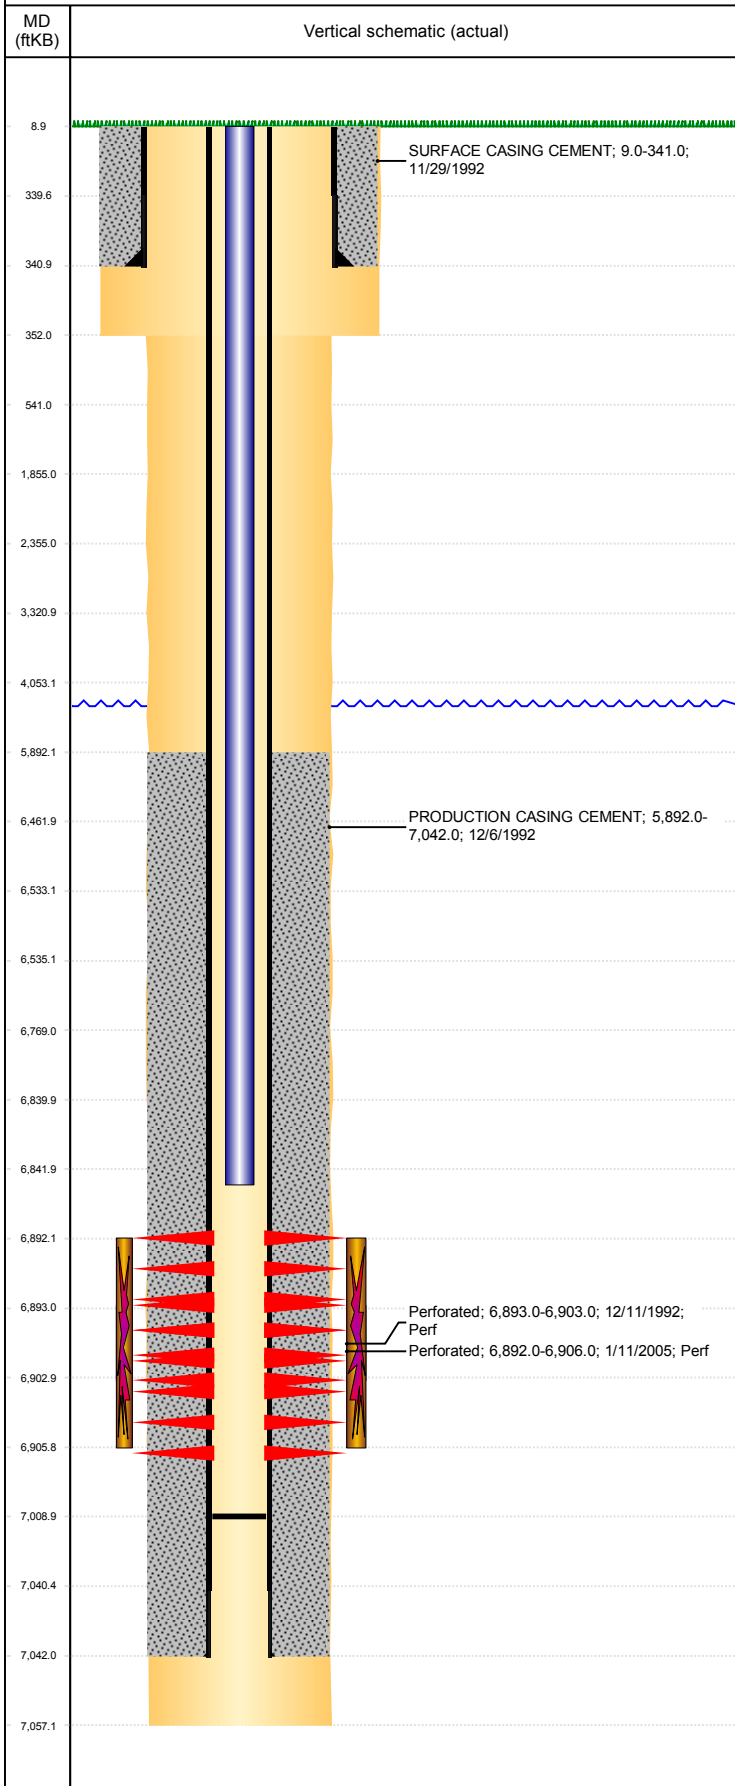

Well Header									
API 05-123-16304		Business Unit DJ BASIN			District 15		Well Config VERTICAL		
KB - GL / MSL (ft... 9.00		Spud Date 11/29/1992		P & A Date		Well Production Status PR			SoRT No
Comment DISCREPANCY: GL ELEV - ST RPT & SCHEMATIC 4643', LOGS 4641'; USED LOG DEPTH.									
Surface Location (Congressional)									
Qtr 3 NW	Qtr 4 SE	Section 36	Twonshp 6	Twonsh... N	Range 65	Rng E/... W	Actual Latitude (°) 40.44028837	Actual Longitude (°) -104.60879452	
Wellbore Sections									
Section Des			Size (in)			Act Top, MD (ftKB)		Act Btm, MD (ftKB)	
SURFACE			12 1/4			9		352	
PRODUCTION			7 7/8			352		7,057	
Casing Strings									
Csg Des		Run Date		OD (in)	Wt/Len (lb/ft)	Grade	Top, MD (ftKB)	MD (ftKB)	
Surface		11/29/1992		8 5/8	23.00	?	9.0	341.0	
Production		12/6/1992		2 7/8	6.50	N-80	9.0	7,042.0	
Cement									
Des				Start Date		Top (ftKB)		Btm (ftKB)	
SURFACE CASING CEMENT				11/29/1992		9.0		341.0	
PRODUCTION CASING CEMENT				12/6/1992		5,892.0		7,042.0	
Zone Statuses									
Zone Name		Status Date	Status	Fluid Type	Job			Prod Method	
CODELL		1/22/1993	PR	Oil	DRILLING/COMPLETION - ORIGINAL, 11/29/199...				
CODELL		1/15/2005	PR	Oil	RE-FRAC, 1/7/2005 00:00				
Perforation Data									
Linked Zone		Bnch/Stg	Entered Shot Total	Top (ftKB)		Btm (ftKB)		Date	
CODELL, ORIGINAL HOLE			56	6,892.00		6,906.00		1/11/2005	
CODELL, ORIGINAL HOLE			40	6,893.00		6,903.00		12/11/1992	
Stimulation Intervals									
Zone				Start Date		Top (ftKB)		Btm (ftKB)	
CODELL, ORIGINAL HOLE				1/14/2005		6,892.0		6,906.0	
CODELL, ORIGINAL HOLE				12/16/1992		6,893.0		6,903.0	
Other In Hole									
Run Date		Des				OD (in)	Top (ftKB)	Btm (ftKB)	
Logs									
Date		Type				Top, MD (ftKB)		Btm, MD (ftKB)	
12/5/1992		COMPENSATED DENSITY				3,480.0		7,036.0	
12/5/1992		INDUCTION				3,480.0		4,480.0	
12/11/1992		CEMENT BOND				3,480.0		7,036.0	
Plug Back Total Depths									
Date		Type		Com				Depth (ftKB)	
12/11/1992		FILL		DEPTH LOGGER ON CBL				7,021.0	
1/10/2005		FILL		CLN OUT				7,009.0	