


PIT STATUS EVALUATION FORM

Facility ID: 115172

Pit Name: RUNNING CREEK STATE 16, 14, 6

☐ Duplicate Record(s) Pit #

111261, 115174, 115173

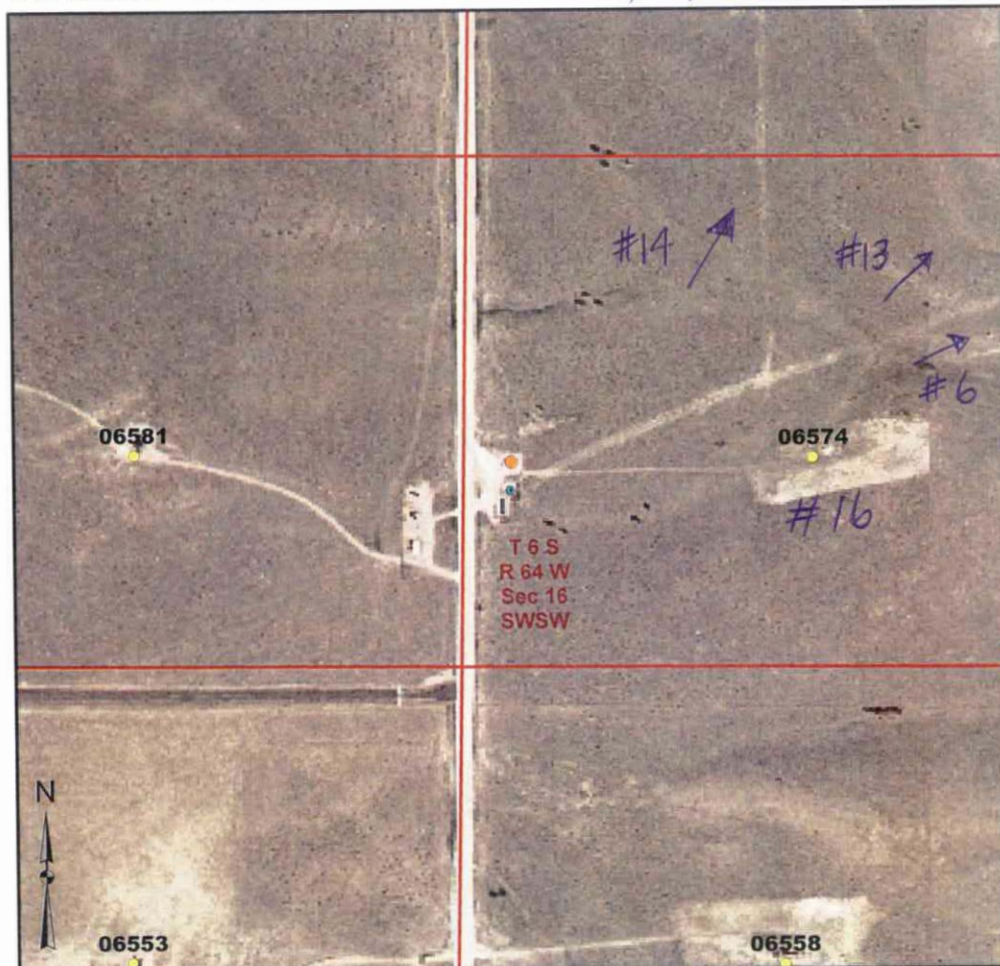

Legend

- Producing or Shut In Well
- ⚡ Temp Aban Well
- ⚡ Abandoned Well
- ⚡ Dry & Aban Well
- Earthen Pit
- Culvert
- ✱ Backfilled Pit(s)
- Vault
- Fiberglass Tank
- Steel Tank(s)
- | Separator
- Wellhead
- Earthen Pit Extent
- Area of Disturbance
- Backfilled Pit Extent
- Tank Fence

1:6,000

0 250 500 750 Feet

Image Source:
USDA National Agricultural Imagery
Program (NAIP), 2006

S.S. PAPADOPULOS & ASSOCIATES, INC.

COGCC Database Information

Status: NR Owner: SMITH ENERGY CORP
T: 6S R: 64W Sec: 16 QQ: SWSW 6th Meridian
Latitude: 39.522252 Longitude: -104.569267 NAD83

County: Elbert, CO
County Code: 039

Pit Status Evaluation

☐ Active

☐ Form 15: Pit Permit NA Assoc. Well Seq No(s) 06510 #6, 06588 #14, 06574 #16
☐ Other documentation _____
☐ Aerial photo verification _____

☒ Closed

☐ Form 27: Remediation Workplan _____
☐ Form 4: Sundry Notice _____
☐ Rule 903a.(2)B _____
☐ Evidence pit(s) existed, no closure docs & well not PR, AC or SI
Well API Seq #(s) _____
☐ Other documentation FIR #200

☐ Abandoned

☐ Possible un-reclaimed pit(s) or adverse conditions, no closure docs

☒ Site Visit
☐ No Site Visit
☐ Add'l Review

☐ Unknown

Notes: Common Use Battery Tank Site for Running Creek State #16, #14, #6
UF (1987) 30'x30' skimpit. FIR (1996) "earthen pit w/screen, oil & H₂O in pit"
FIELD VISIT 6-3-2008: NO SIGN OF PIT. PIT BACKFILLED.

Facility ID 115172
Well API 05-039-06574
Well API 05-039-06510
Well API 05-039-06588

Running Creek 16, 14 & 6
Running Creek 16
Running Creek 6
Running Creek 14

June 3, 2008



Photo 1. Tank battery sign

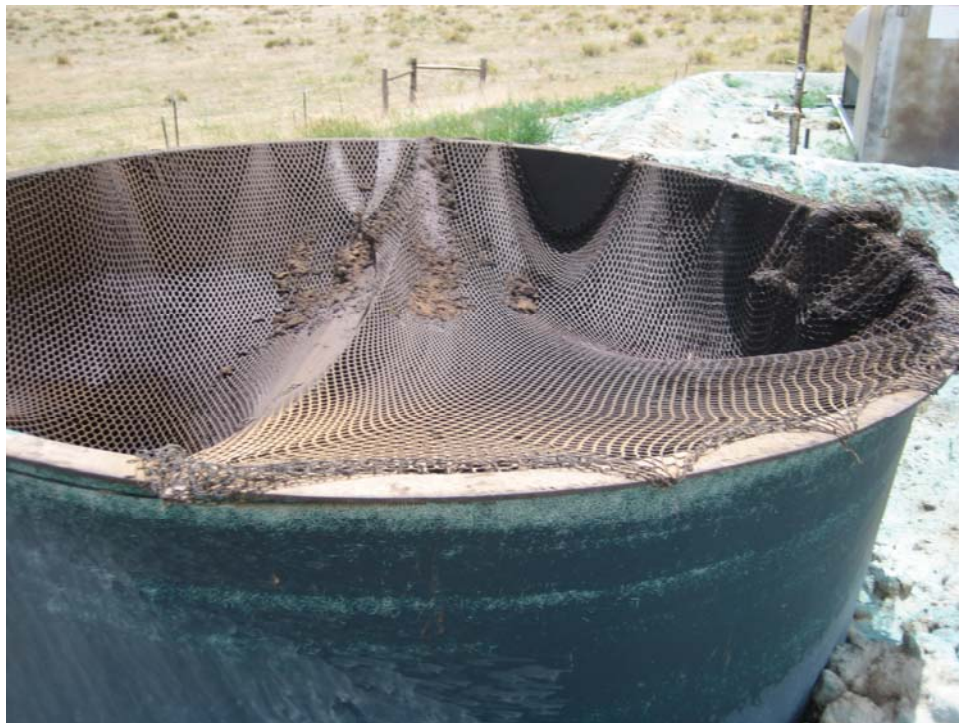


Photo 2. Covered fiberglass tank

Facility ID 115172

Well API 05-039-06574

Well API 05-039-06510

Well API 05-039-06588

Running Creek 16, 14 & 6

Running Creek 16

Running Creek 6

Running Creek 14

June 3, 2008



Photo 3. Fiberglass tank and berm