13

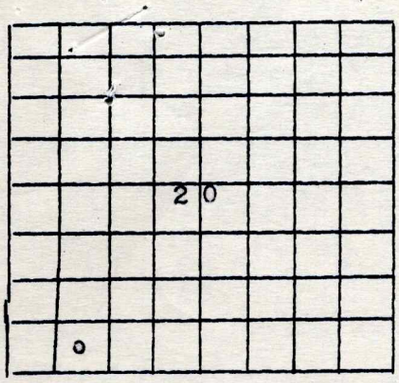

Locate
Well
Correctly

OFFICE OF STATE OIL INSPECTOR
Oil and Gas Conservation
Department

- - -

LOG OF OIL AND GAS WELL

00193482

Company Trigood Oil Company Address Box 1689, Casper, Wyoming
~~State~~ Patented Field Merino State Colorado
Well No. Kilmer 1 Sec. 20 T. 6 N. R. 54 W. Meredian 6th County Logan
Location 330 Ft. ~~X~~(N) of S. Line and 990 Ft. ~~X~~(E) of W. line of Sec. 20 / Elevation 4251 (KB)
(Derrick floor relative to sea level)

The information given herewith is a complete and correct record of the well and all work done thereon so far as can be determined from all available records.

Signed J. L. Fusselman
Date January 16, 1951 Title J. L. Fusselman, Asst. Mgr.

The summary on this page is for the condition of the well as above date.
Commenced drilling October 3, 1950 Finished Drilling October 18 1950

OIL SANDS OR ZONES

No. 1, from 5060 to 5094 No. 4, from _____ to _____
No. 2, from _____ to _____ No. 5, from _____ to _____
No. 3, from _____ to _____ No. 6, from _____ to _____

IMPORTANT WATER SANDS

No. 1, from _____ to _____ No. 3, from _____ to _____
No. 2, from _____ to _____ No. 4, from _____ to _____

CASING RECORD

Size	Weight per ft.	Threads per inch	Make	Amount	Kind of Shoe	Cut & Pulled from	Perforated From	Perforated to	Purpose
10 3/4	40	8		183	Guide				Surface
5 1/2	14	8	J-55	-	Larkin Cementrol				Production

MUDDING AND CEMENTING RECORD

Size	Where Set	No. Sacks of Cement	Methods used	Mud Gravity	Amount of Mud Used
10 3/4	195	100	Howco	-	
5 1/2	5060	150	Howco		

PLUGS AND ADAPTERS

Heaving plug-Material _____ Length _____ Depth Set _____
Adapters-Material _____ Size _____

SHOOTING RECORD

Size	Shell Used	Explosive Used	Quantity	Date	Depth Shot	Depth Cleaned Out

TOOLS USED

Rotary Tools used from Entirely ft. to _____ ft. and from _____ ft. to _____ ft.
Cable tools were used from _____ ft. to _____ ft. and from _____ ft. to _____ ft.

DATES

January 16 1951 Put to producing November 2 1950

The production for the first 24 hours was 344 barrels of fluid of which 100 % was oil, _____ % emulsion; trace % sediment. Gravity ~~Be~~, 39.6° API
If gas well, cu. ft. per 24 hours _____ Gallons gasoline per 1,000 cu. ft. of gas _____. Rock Pressure, lbs. per sq. in _____

EMPLOYES

W. Swinton Driller W. K. Murray, Driller
R. L. Robie Driller Reserve Drilling Co., Driller

FORMATION RECORD

From	To	Total Feet	Formation
4000	4125	125	Shale, black, flakey, bentonitic bent. strks.
4125			NIOBRARA
4125	4155	30	Shale, black w/brown marl spots
4155	4170	15	Marl, lt. gr.; I.P.

JDM/mbl

2