


CERTIFICATE OF SURVEY
for
Jim Snyder Drilling Co.
Weld County, Colorado

RECEIVED

MAR - 4 1971

COLORADO OIL & GAS CONS. COMM.

BEST COPY
AVAILABLE

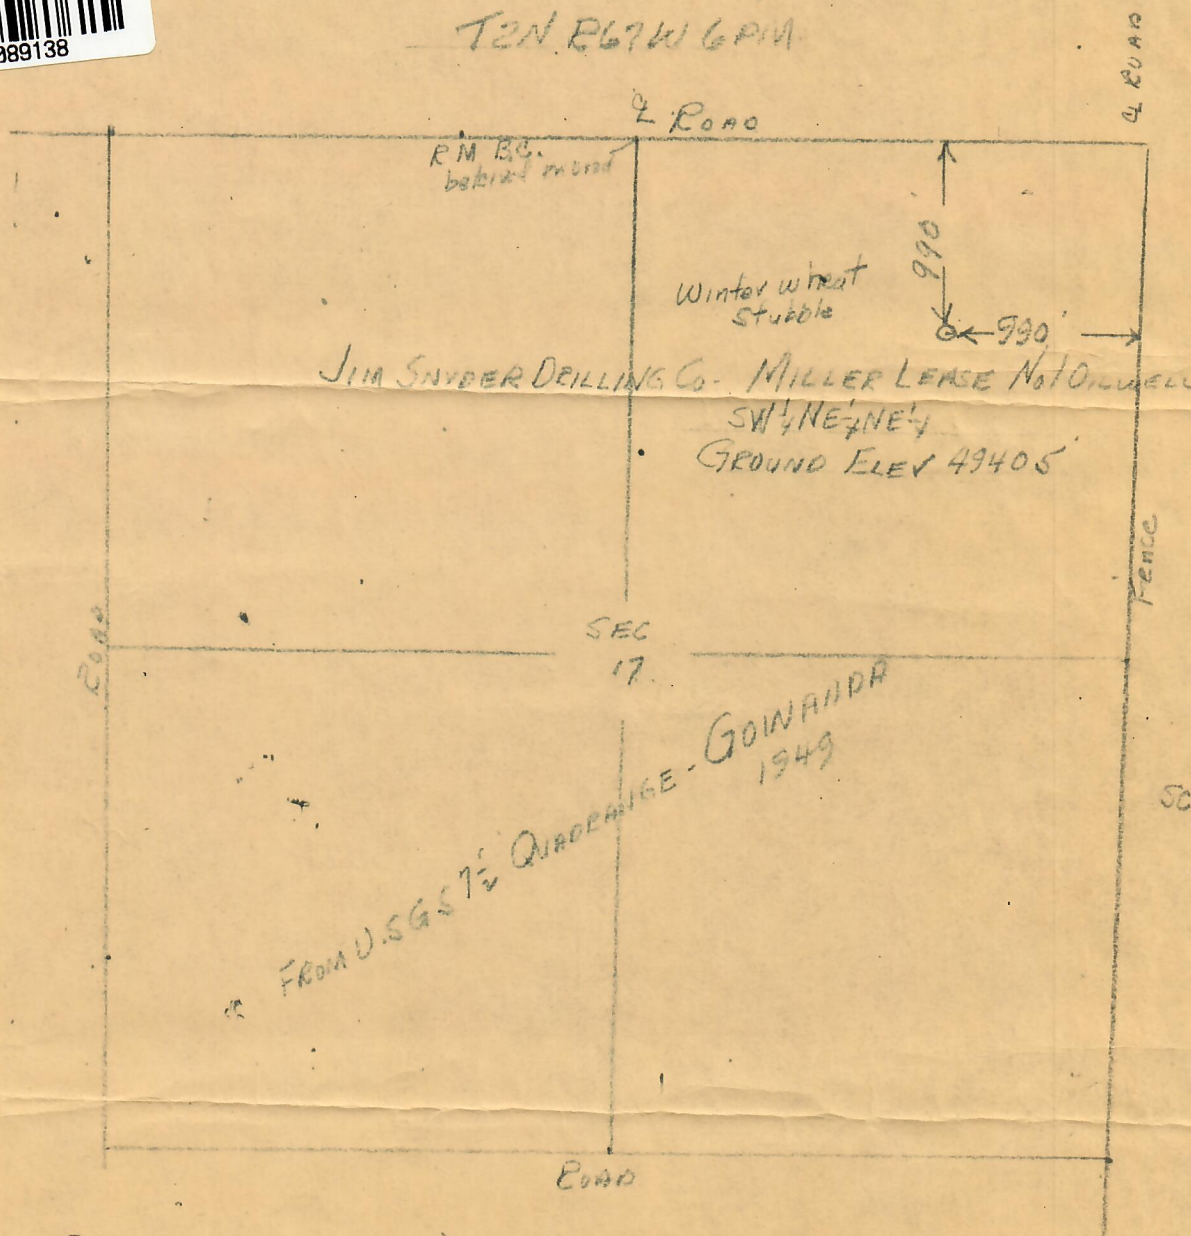

I hereby certify that the above plat is an accurate representation of a correct survey showing the location of Jim Snyder Drilling Co.- Miller Lease No. 1 Oilwell in SW 1/4 NE 1/4 NE 1/4 Sec. 17 T2N R67W 6PM. The elevation of the ground at the stake is 4940.5 feet above sea level from U.S.G.S. Bench Mark.

Fort Morgan, Colorado
Feb. 28, 1971

Local J. Osborne
Registered Professional Engineer
State of Colorado

71-129