


WELLBORE DIAGRAM
 S & D LLC
 DANIEL KISSLER #1-9
 SESE SEC 9 4S 64W
 ARAPAHOE COUNTY
 05-005-06877

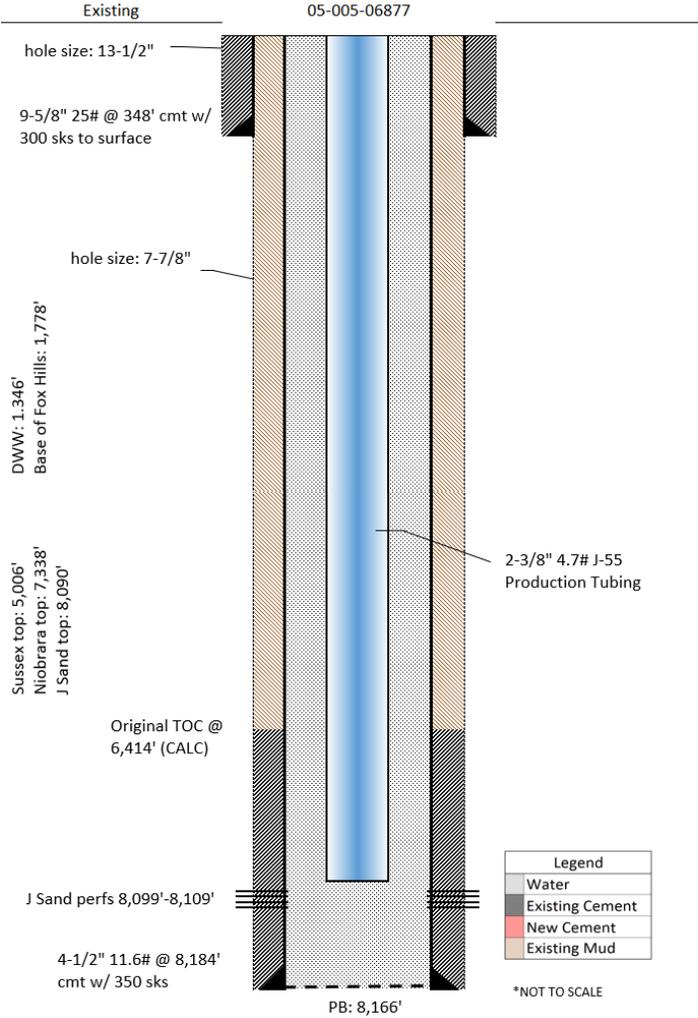

Legend	
[Blue Box]	Water
[Grey Box]	Existing Cement
[Red Box]	New Cement
[Orange Box]	Existing Mud

*NOT TO SCALE