

Inspection Photos

4/26/2019

Operator: VERDAD RESOURCES LLC # 10651

Location ID: 462872

Inspection Doc. Number: 682504821

Weld County, CO

Aaron Trujillo
NE Reclamation Specialist
COGCC



Photo 1: Photo taken from the northeast corner of the location, facing south. Photo shows survey stakes. Operator states within FIRR 401983658 that location was re-surveyed, and that the location has been constructed within the stakes. Photo shows that there area areas of the location's disturbance beyond the survey stakes on the north end of the photo.

Inspection Photos
Operator: VERDAD RESOURCES LLC # 10651
Location ID: 462872



Photo 2: Photo taken from the northeast corner of the location, facing west. Operator states within FIRR 401983658 that location was re-surveyed, and that the location has been constructed within the stakes. Photo shows that there are areas of the location's disturbance beyond the survey stakes on the north end of the location.

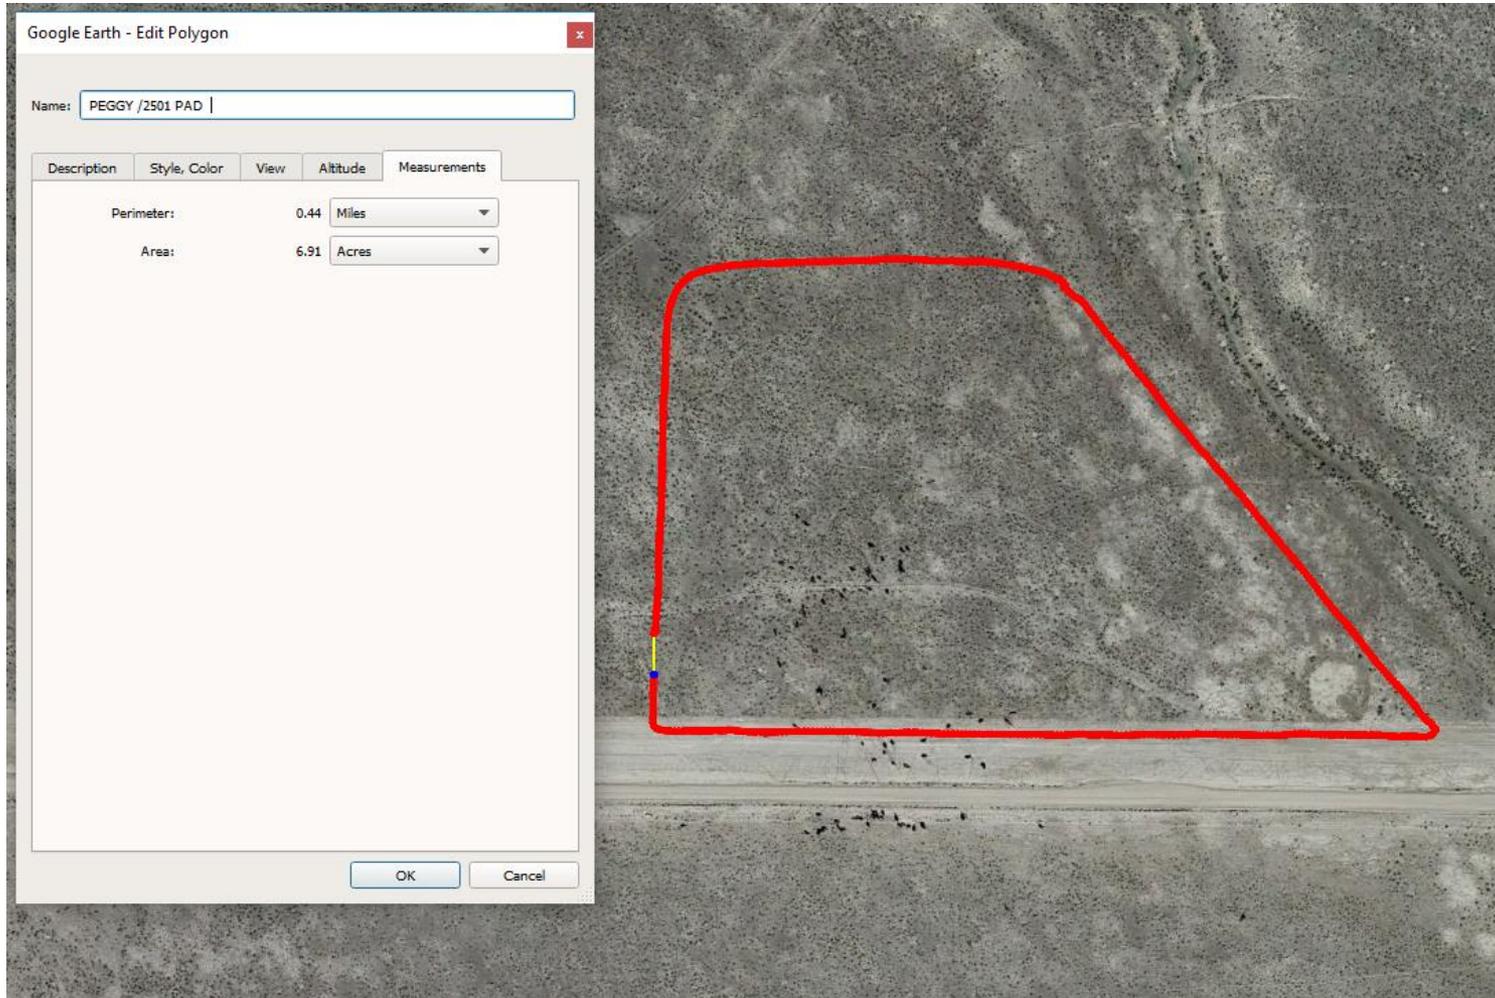


Photo 3: On 4/26/2019, inspector mapped the perimeter disturbance area (stormwater ditch, pad, soil stockpiles), not including the access road, with a Trimble Juno 3B GPS unit. Photo shows a disturbance area of 6.9 acres; this appears to exceed the permitted disturbance area per the approved Form 2A.