


**Well Name: GUTTERSEN 42-23**

VERTICAL, ORIGINAL HOLE, 5/1/2019 11:20:44 AM

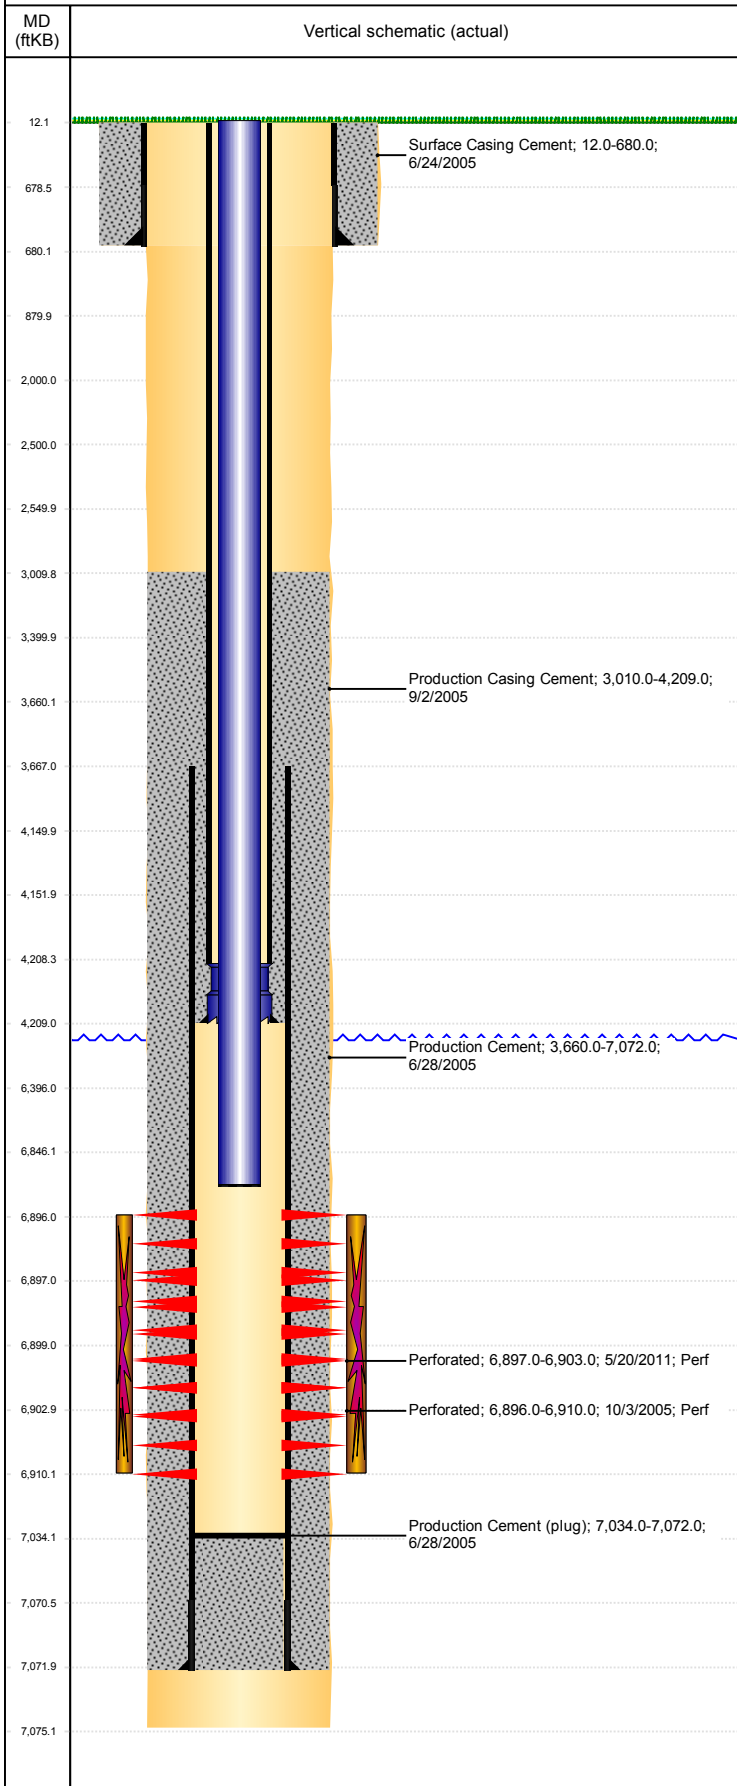

## Well Header

API 05-123-20804	Business Unit DJ BASIN	District 15	Well Config VERTICAL
KB - GL / MSL (ft... 12.00	Spud Date 6/23/2005	P & A Date	Well Production Status PR
SoRT No			

Comment  
CASING REPAIR 2 7/8" TUBING WITH NOTCHED COLLAR SET AT 4209'  
PRODUCTION CSG INFO MISSING IN FILE, JOINTS PULLED AND SET NOT AVAILABLE

## Surface Location (Congressional)

Qtr 3 SE	Qtr 4 NE	Section 23	Twntshp 3	Twntsh... N	Range 64	Rng E/... W	Actual Latitude (") 40.21259696	Actual Longitude (") -104.51133337
-------------	-------------	---------------	--------------	----------------	-------------	----------------	------------------------------------	---------------------------------------

## Wellbore Sections

Section Des	Size (in)	Act Top, MD (ftKB)	Act Btm, MD (ftKB)
SURFACE	12 1/4	12	680
PRODUCTION	7 7/8	680	7,075

## Casing Strings

Csg Des	Run Date	OD (in)	Wt/Len (lb/ft)	Grade	Top, MD (ftKB)	MD (ftKB)
Surface	6/24/2005	8 5/8	24.00	J-55	12.0	680.0
Production	9/2/2005	2 7/8	6.50	N-80	12.0	4,209.0
Production	6/28/2005	4 1/2	11.60	N-80	12.0	7,072.0

## Cement

Des	Start Date	Top (ftKB)	Btm (ftKB)
Surface Casing Cement	6/24/2005	12.0	680.0
Production Cement	6/28/2005	3,660.0	7,072.0
Production Casing Cement	9/2/2005	3,010.0	4,209.0

## Zone Statuses

Zone Name	Status Date	Status	Fluid Type	Job	Prod Method
CODELL	10/7/2016	SI			
CODELL	3/9/2017	PR			

## Perforation Data

Linked Zone	Bnch/Stg	Entered Shot Total	Top (ftKB)	Btm (ftKB)	Date
CODELL, ORIGINAL HOLE		56	6,896.00	6,910.00	10/3/2005
CODELL, ORIGINAL HOLE		24	6,897.00	6,903.00	5/20/2011

## Stimulation Intervals

Zone	Start Date	Top (ftKB)	Btm (ftKB)
CODELL, ORIGINAL HOLE	10/5/2005	6,896.0	6,910.0
CODELL, ORIGINAL HOLE	6/1/2011	6,896.0	6,910.0

## Other In Hole

Run Date	Des	OD (in)	Top (ftKB)	Btm (ftKB)

## Logs

Date	Type	Top, MD (ftKB)	Btm, MD (ftKB)
6/27/2005	DENSITY/INDUCTION	6,450.0	7,075.0
8/9/2005	CBL/CCL/GR	2,190.0	6,894.0
9/20/2017	GYRO	0.0	6,800.0

## Plug Back Total Depths

Date	Type	Com	Depth (ftKB)
8/9/2005	CEMENT PLUG	DEPTH LOGGER ON CBL	6,899.0
5/19/2011	FILL	C/O	7,034.0