

After Plugging:

8 5/8" 24# Surface Set @ 230' MD


Cement Plug from 280' - Surface

Cement plug from 393' - 800' MD

Cement plug from 1190' - 1510' MD

Cement plug from 2620' - 3000' MD

7 7/8" Open Hole TD @ 8275' MD

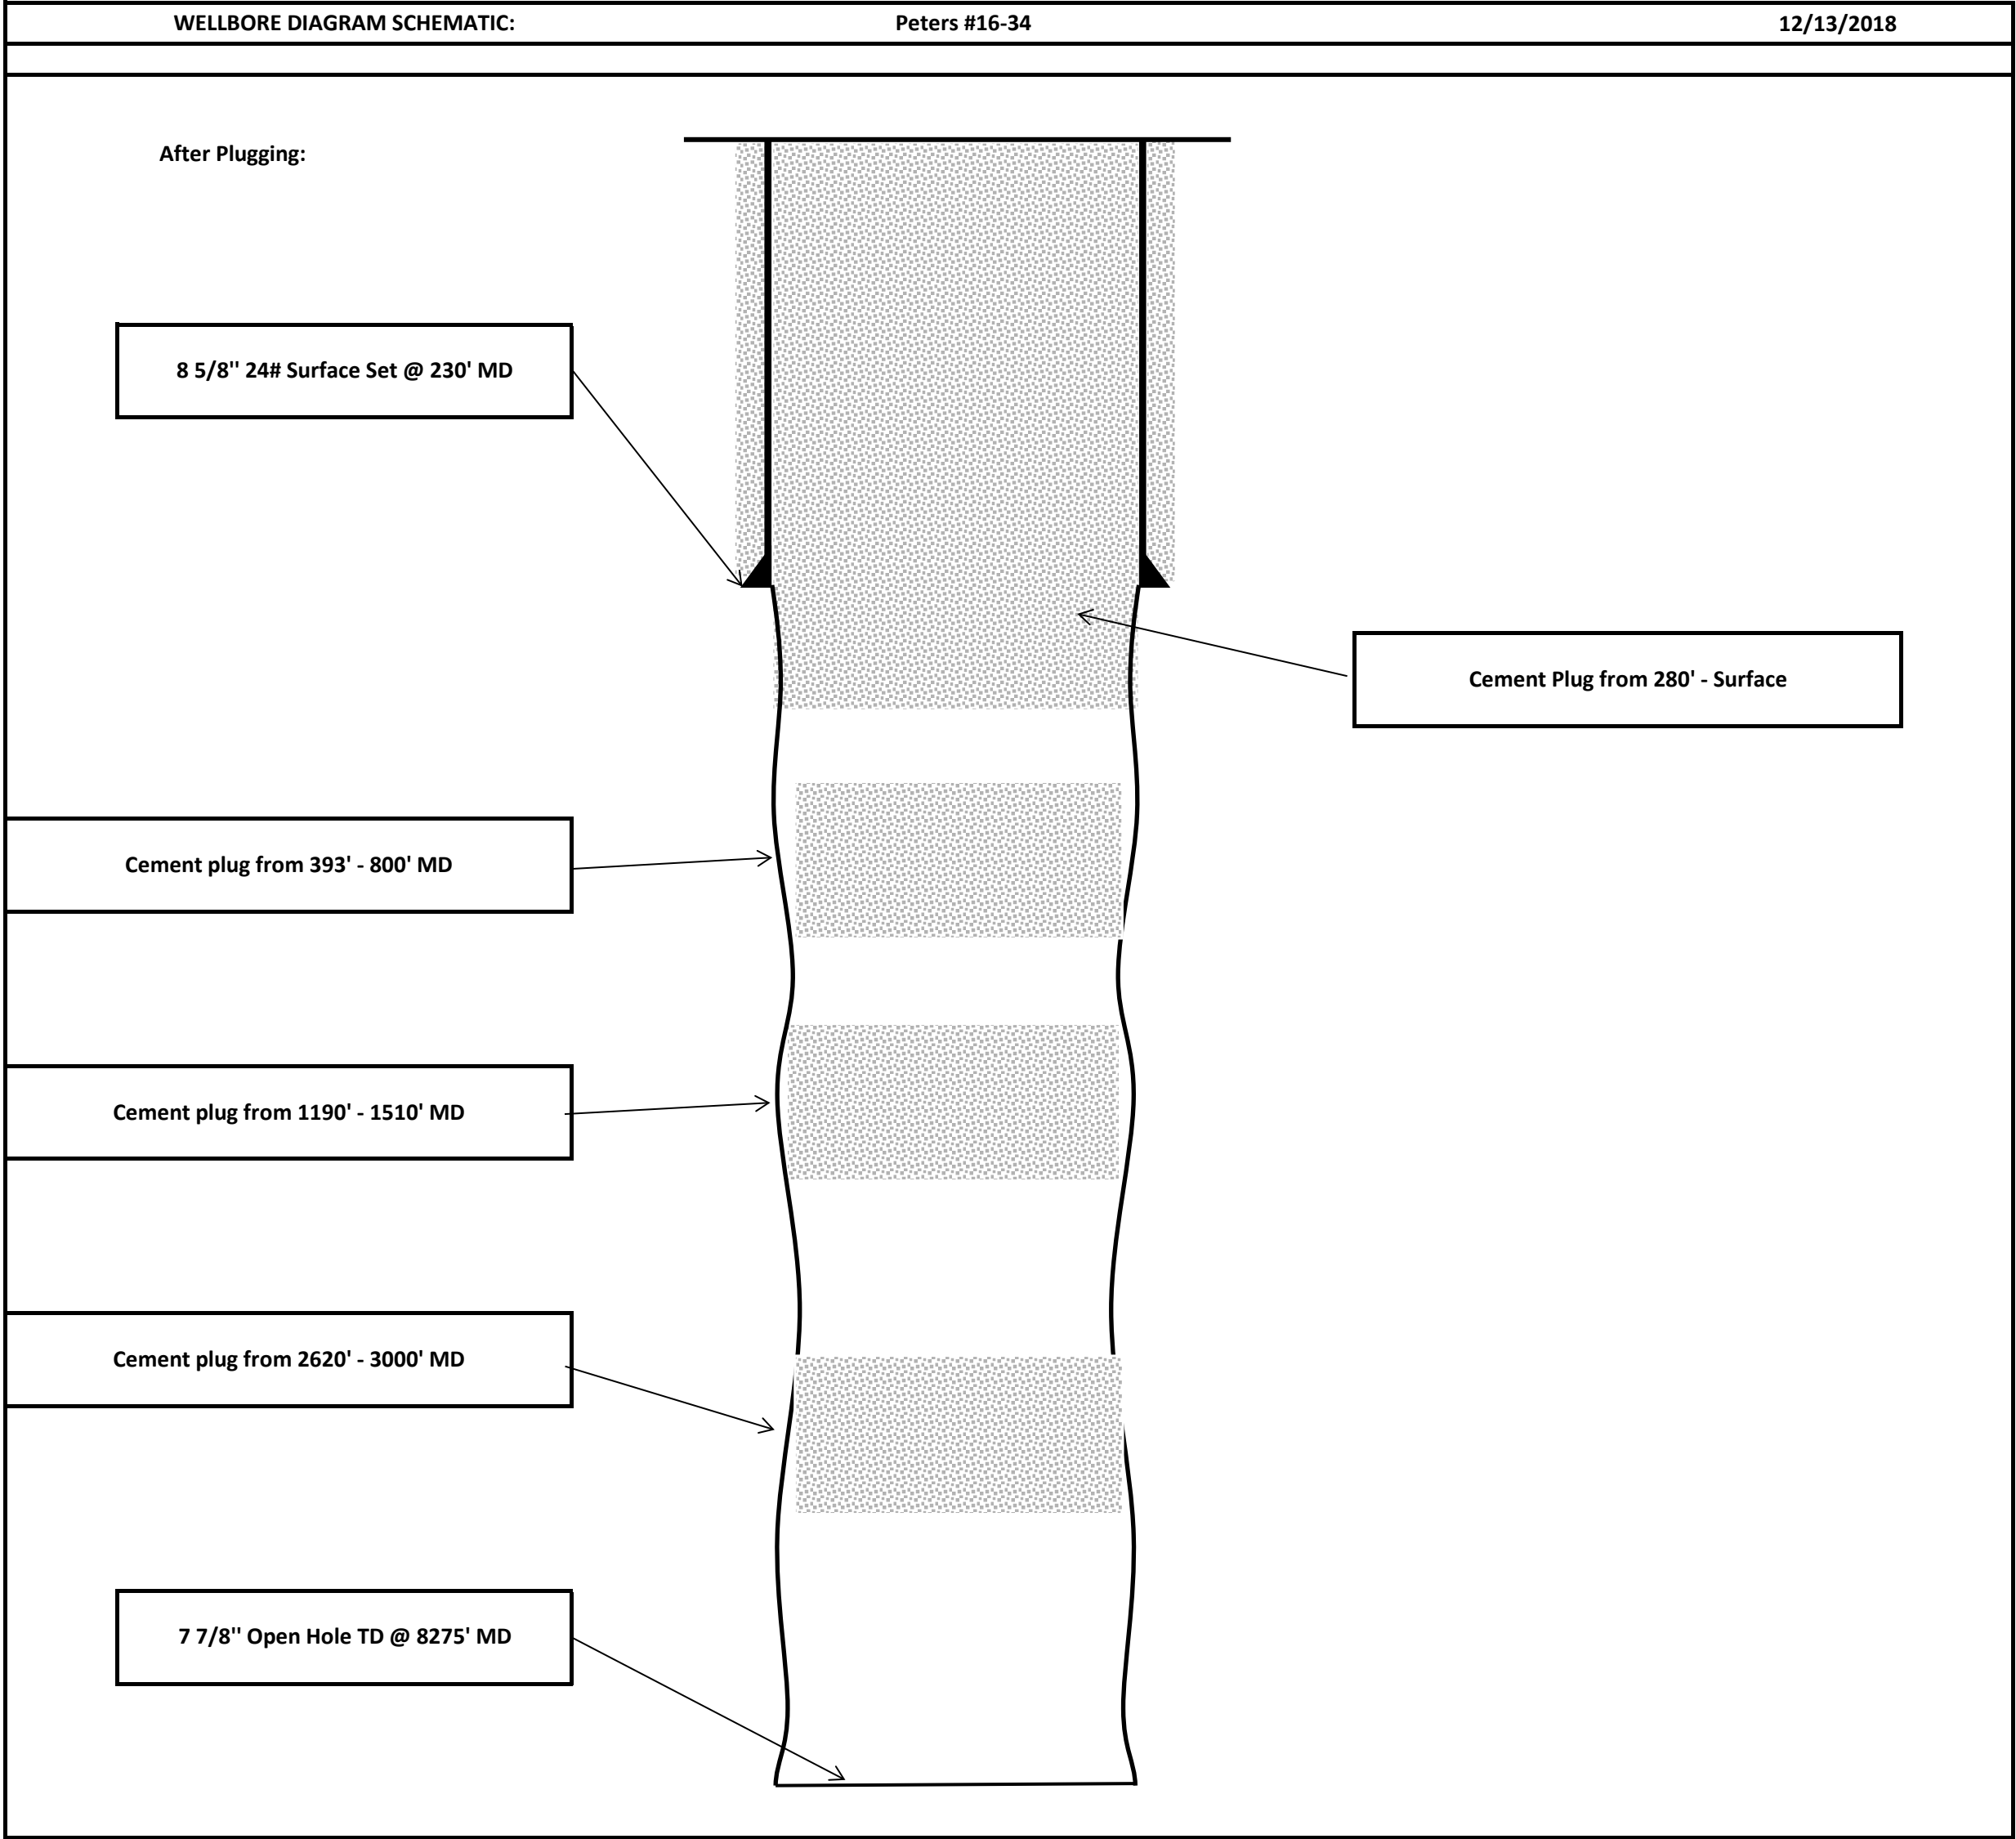

Before Plugging:

8 5/8" 24# Surface Set @ 230' MD

Cement Plug from 28' - Surface

Cement Plug from 250' - 210'

7 7/8" Open Hole TD @ 8275' MD

