


Well Completion Diagram

API Well No: 05-087-07047-00-		Well Name: PETERSEN I	
Owner: CORAL PRODUCTION CORP	County: MORGAN	Field: PETERSON	Pool:
Coordinates: X 1320 FEL	Y 660 FSL	Sec: 17	Twp: 2N Rng: 56W

Note: Changes to the drawing do not effect the database

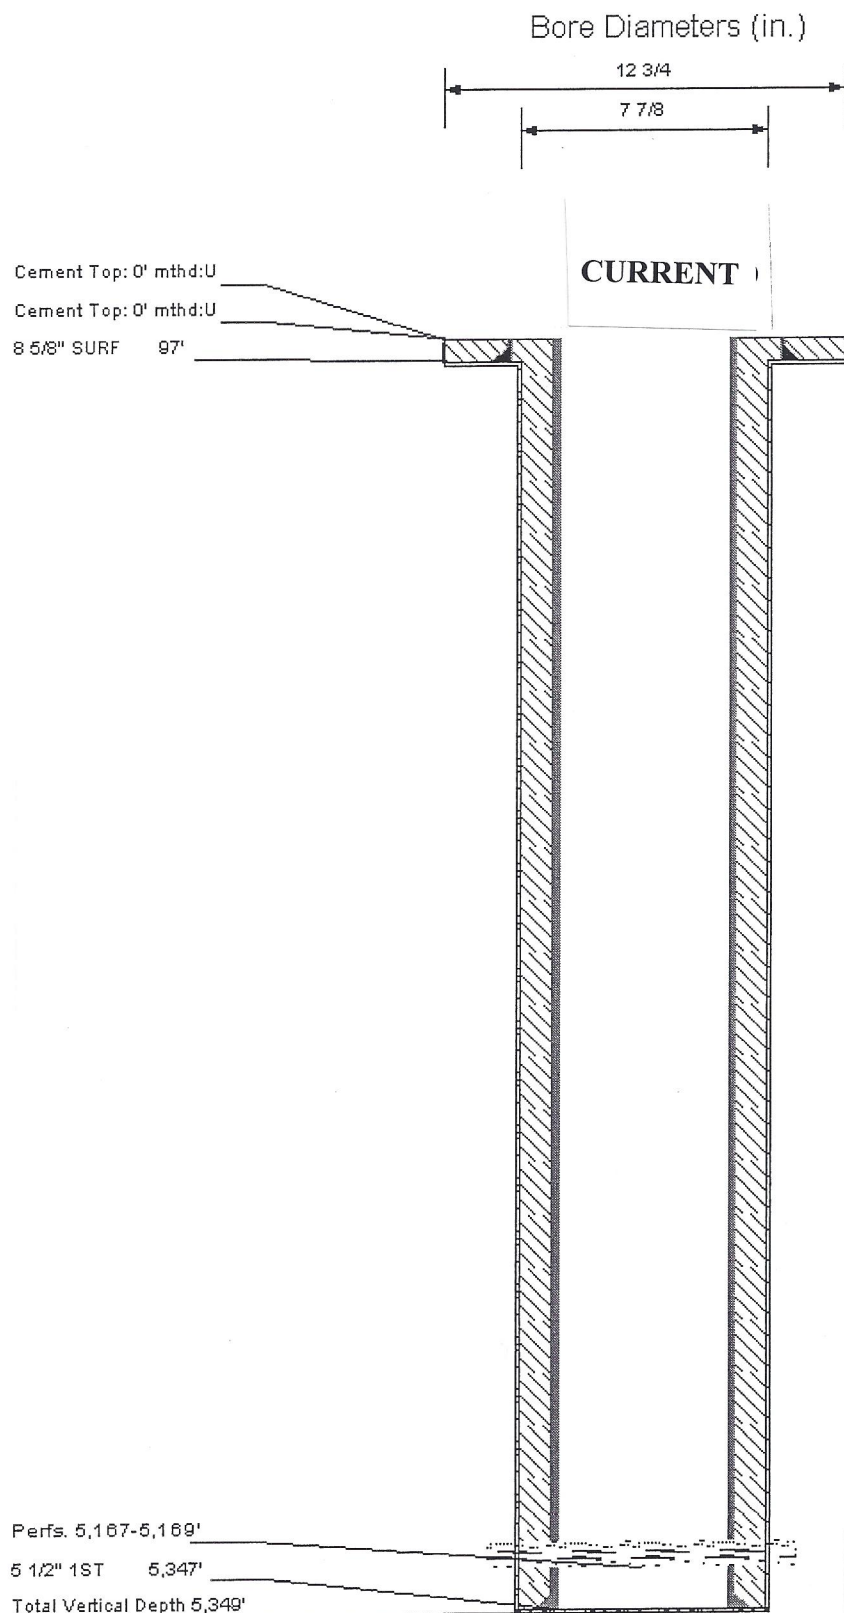

PBTD - 5312'

Well Completion Diagram

API Well No: 05-087-07047-00-					
Owner:	CORAL PRODUCTION CORP			Well Name:	PETERSEN /
County:	MORGAN	Field:	PETERSON	Pool:	
Coordinates: X	1320 FEL	Y	660 FSL	Sec:	17
				Twp:	2N
				Rng:	56W

Note: Changes to the drawing do not effect the database

