


# Well Completion Diagram

API Well No: 05-087-07069-00-					
Owner:	CORAL PRODUCTION CORP			Well Name:	PETERSON 2
County:	MORGAN	Field:	PETERSON	Pool:	
Coordinates: X	1750 FEL	Y	630 FNL	Sec:	20
				Twp:	2N
				Rng:	56W


Note: Changes to the drawing do not effect the database

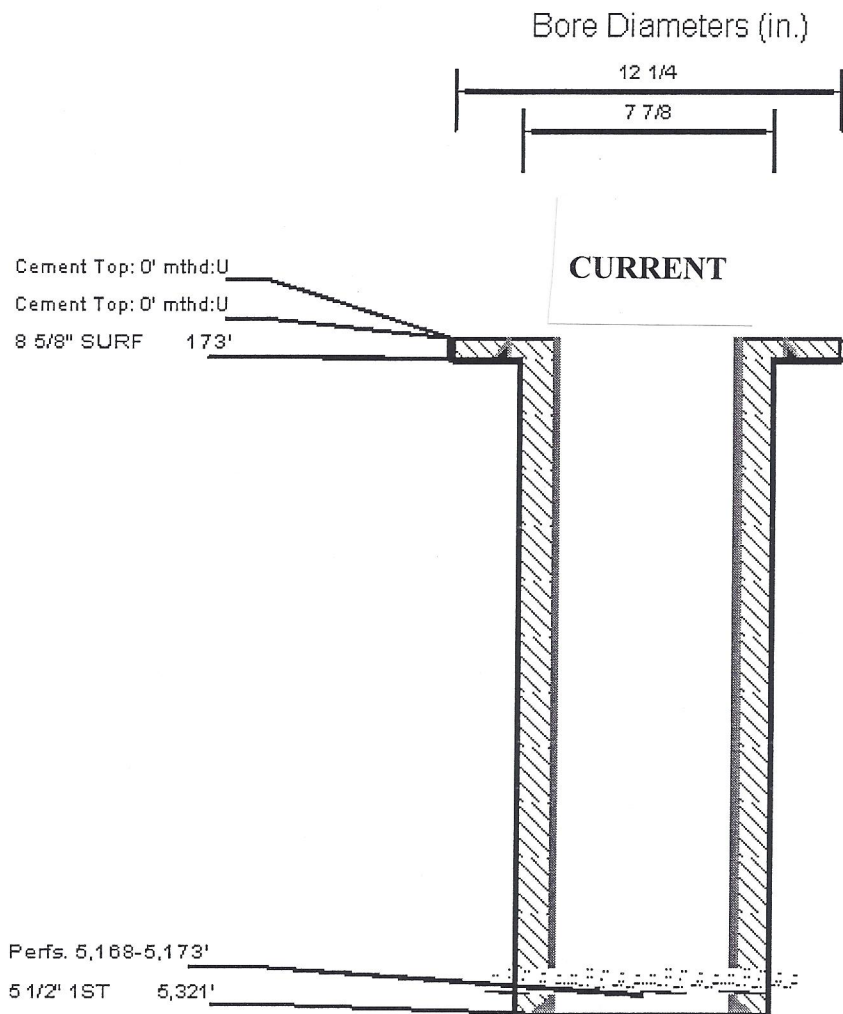

# Well Completion Diagram

API Well No: 05-087-07069-00-							
Owner:	CORAL PRODUCTION CORP			Well Name:	PETERSON 2		
County:	MORGAN	Field:	PETERSON	Pool:			
Coordinates: X	1750 FEL	Y	630 FNL	Sec:	20	Twp:	2N Rng: 56W

Note: Changes to the drawing do not effect the database

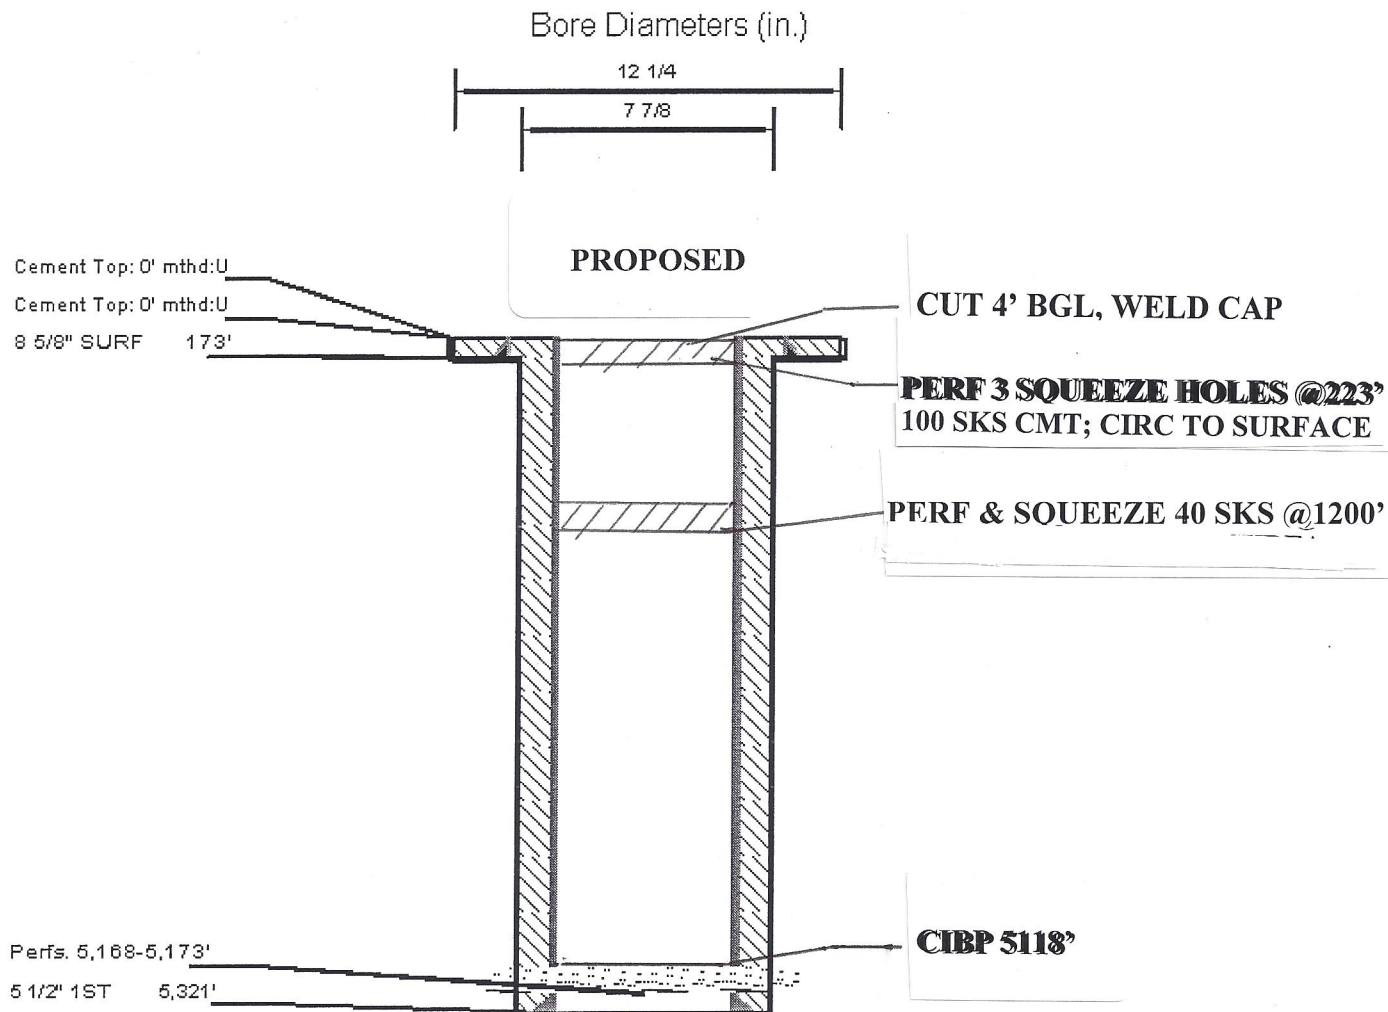

PBTD - 5292'

