



WELL LOCATION SURVEY

PROPERTY OWNERS: _____ & STONE _____

SURVEY OF WELL _____ LOCATED 600' N. & 600' E. of SW Corner

SECTION 1-T35S-R43W COUNTY OF Baca STATE OF Colorado


SURVEYED 11-20-72 PLATTED 11-21-72 FEE WILL BE \$ 112.50

ELEVATION OF WELL LOCATION IS 3055.1

Elevation - 100' S. 3055.4

Elevation - 100' E. 3054.9

Scale:
1" = 1,000 ft.

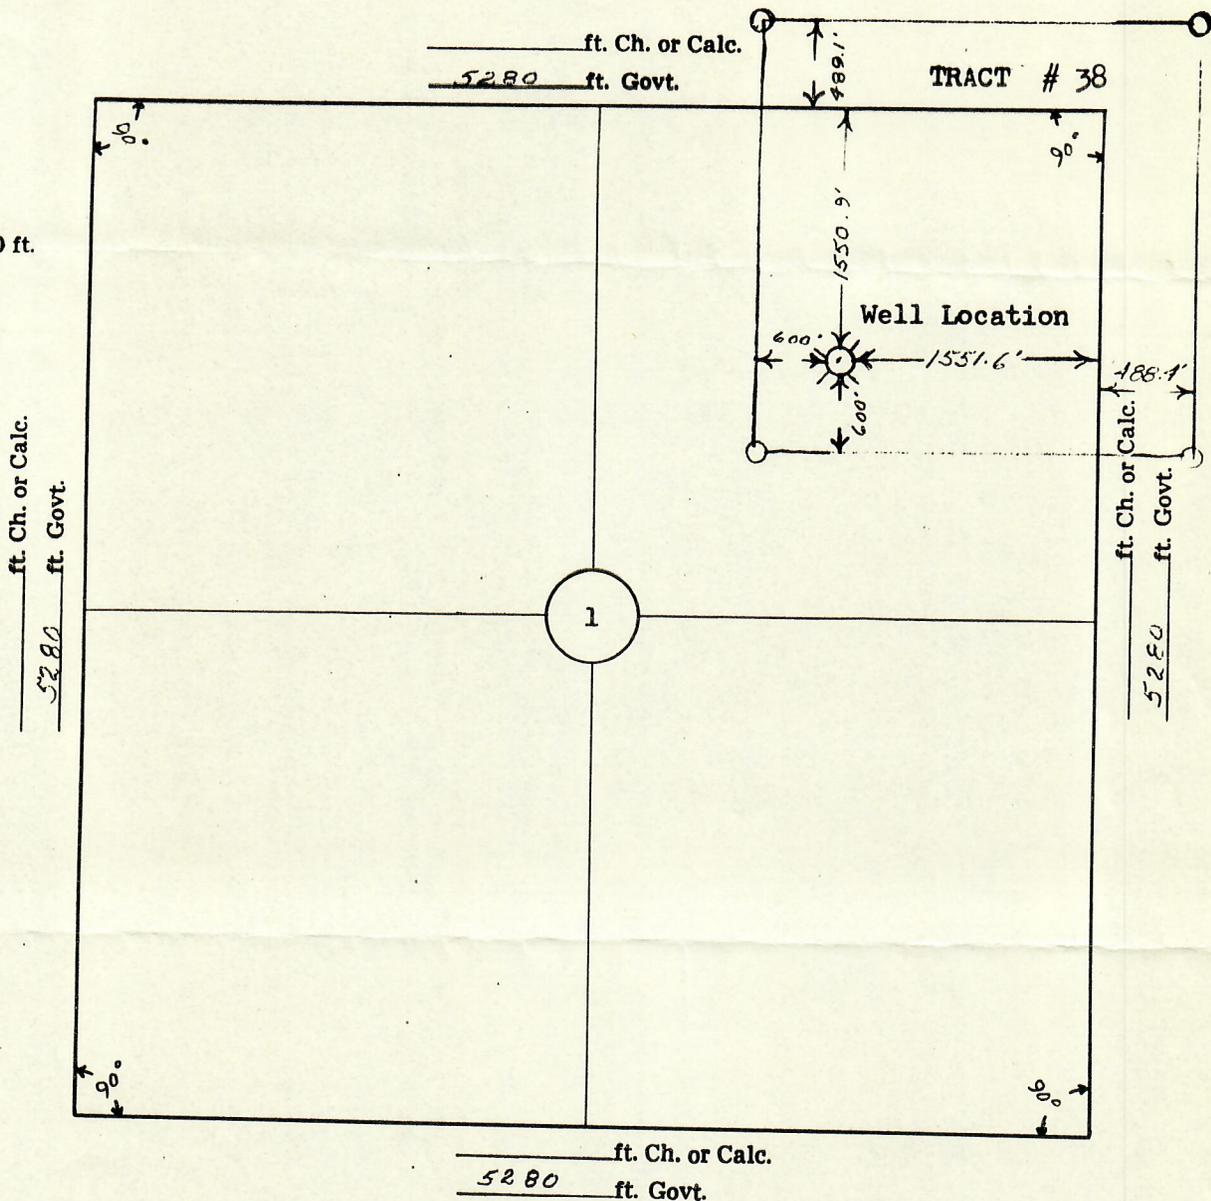

RECEIVED

DEC 4 1972

COLD OIL & GAS COMS. COMM.

72-966

1-358-43W

I, H.C. Williams being a Registered Professional Engineer in the State of Colorado Seal No. 4868 do hereby certify that the above plat represents an accurate survey made under my supervision and that all measurements, bearings and monuments are correctly shown and indicated on the above plat as found or staked in the field as so dated above.

Signed: H.C. Williams

H. C. WILLIAMS AND ASSOCIATES
Consulting Engineer and Surveyors
The Village
Guymon, Oklahoma

Phone: Day 338-6904 — Night: 338-6923 or 338-7254

BEST IMAGE AVAILABLE

Book 538 Page 28