

WELL LOCATION SURVEY


PROPERTY OWNERS: Powell & Stone
 SURVEY OF WELL _____ LOCATED 1980 feet From South Line & 1980 feet From East Line in
 SECTION 1-T35S-R43W COUNTY OF Baca STATE OF Colorado
 SURVEYED June 6, 1974 PLATTED June 7, 1974 FEE WILL BE \$ 171.50



ELEVATION OF WELL LOCATION IS 3740.9
 Elev. 100' West of Loc. is 3742.1
 Elev. 100' North of Loc. is 3741.5

RECEIVED
 JUN 19 1974

N
 Scale:
 1" = 1,000 ft.

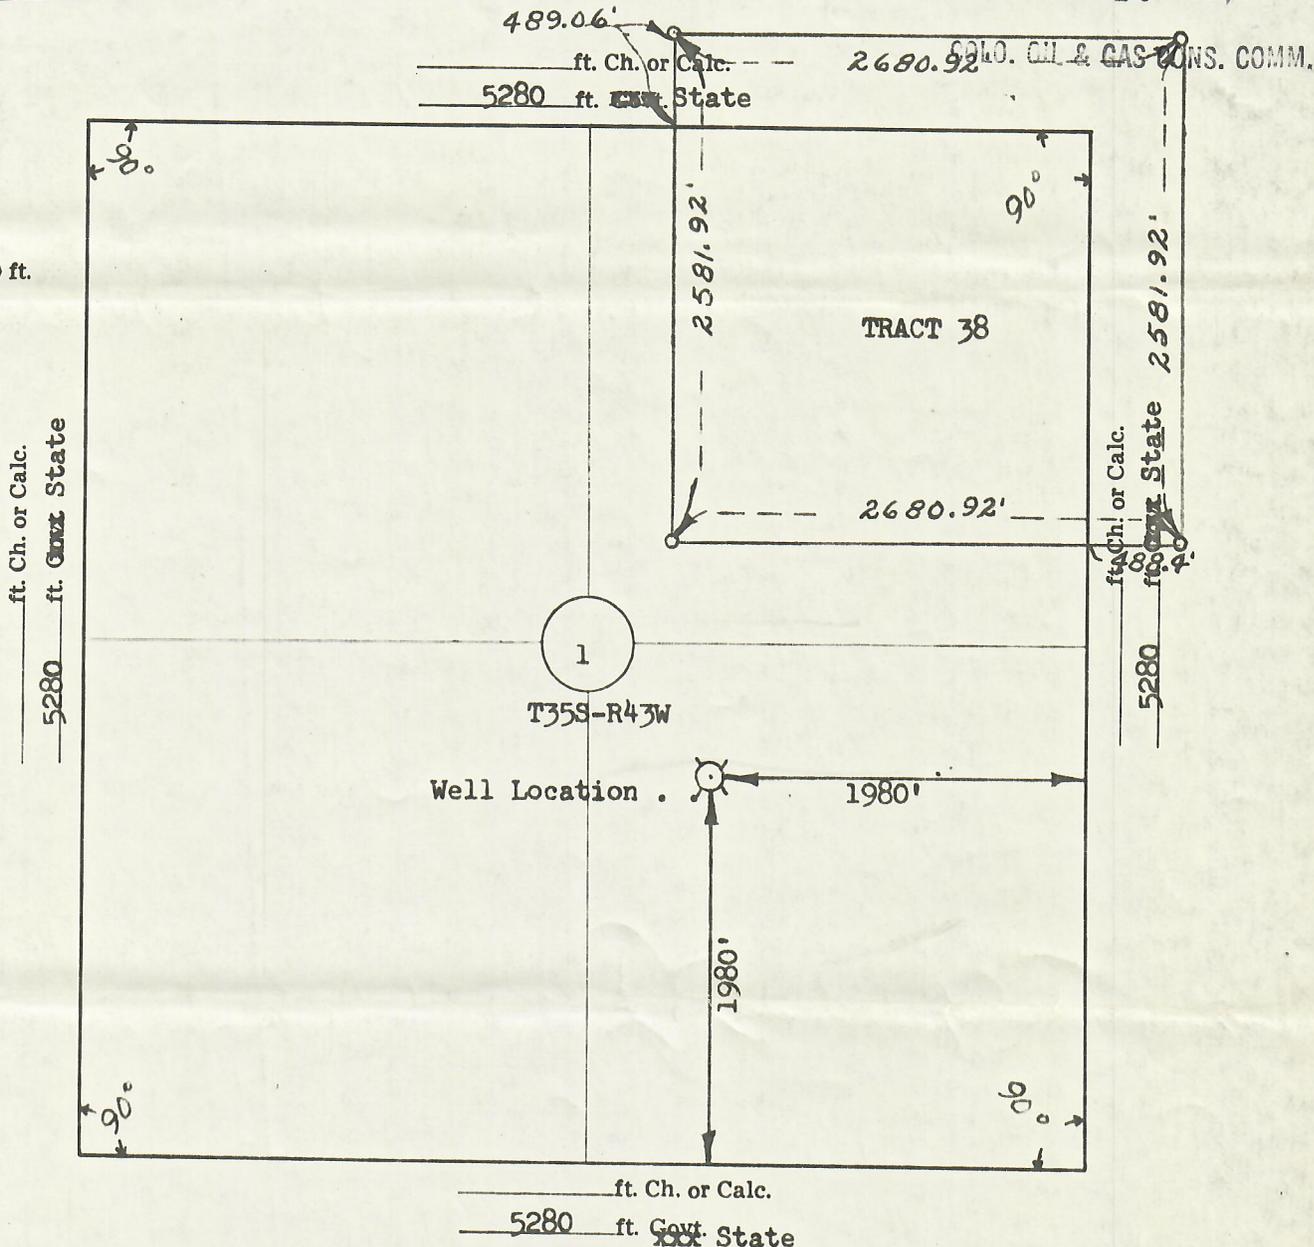

BEST IMAGE
AVAILABLE

I, H. C. Williams being a Registered Professional Engineer in the State of Colorado Seal No. 4868 do hereby certify that the above plat represents an accurate survey made under my supervision and that all measurements, bearings and monuments are correctly shown and indicated on the above plat as found or staked in the field as so dated above.

Signed: H. C. Williams
 H. C. WILLIAMS AND ASSOCIATES
 Consulting Engineer and Surveyors
 The Village
 Guymon, Oklahoma