


LOCATION & ELEVATION VERIFICATION MAP RECEIVED

NOV 25 1981

COLO. OIL & GAS CONS. COMM.



00599493

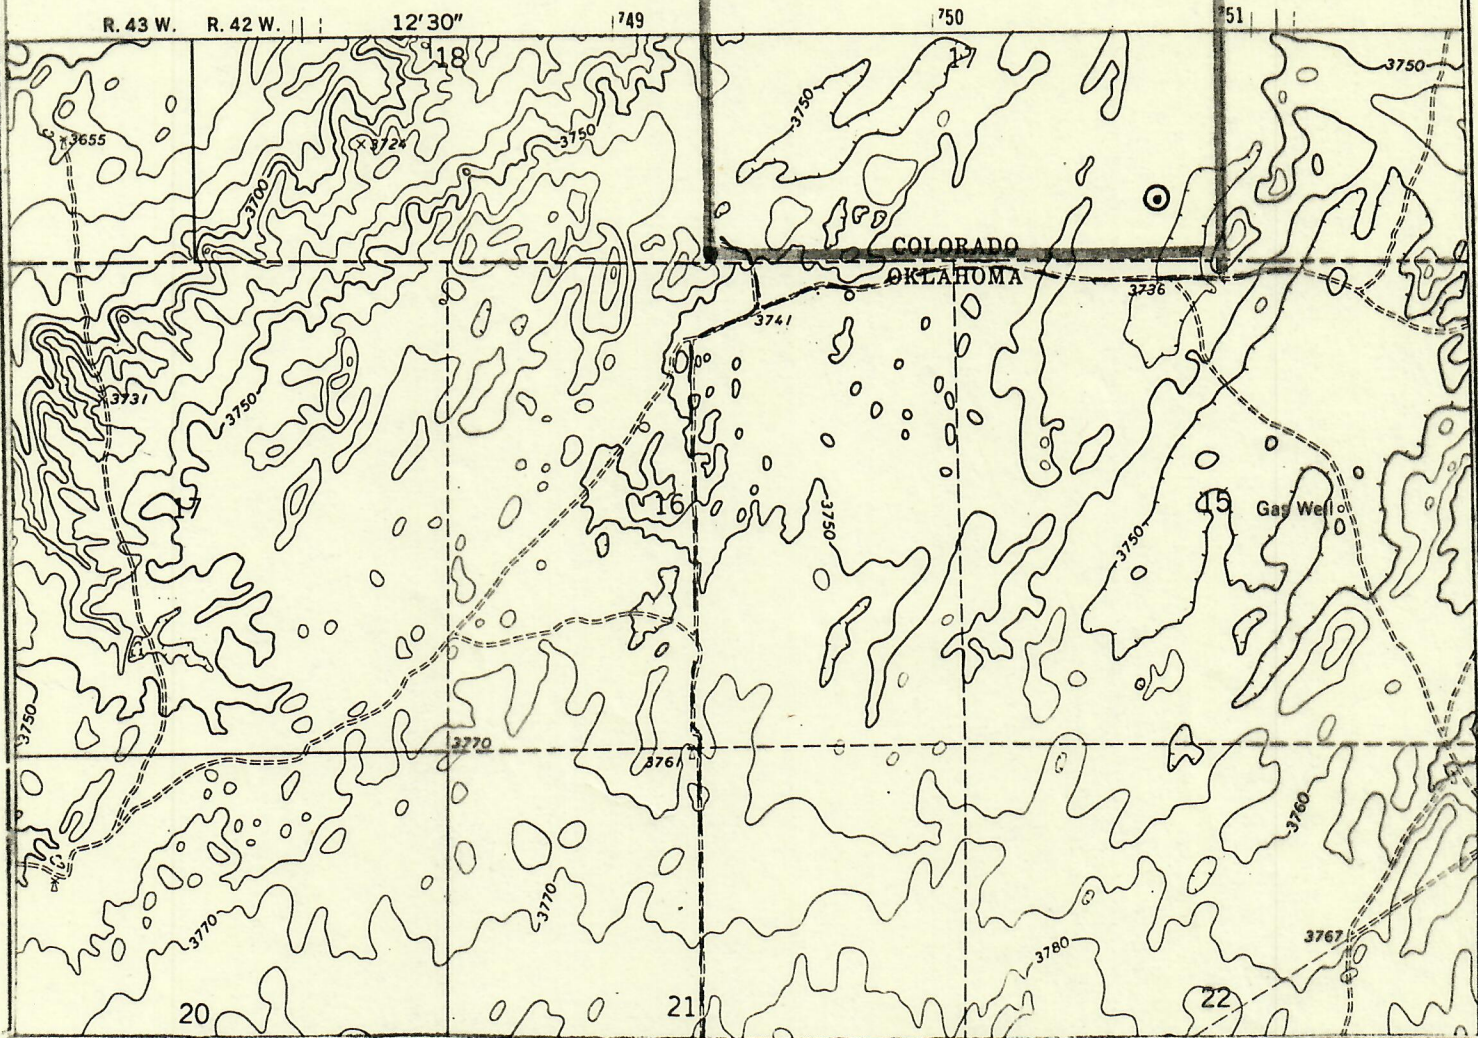

Sec. 17 Twp. 35S Rng. 42W
 County BACA State OK
 Description 600' FSL 600' FEL
 Operator Grand Resources
 Lease Name Cole 1-17
 Well No. _____

Above background data from
 U.S.G.S Topographic Map

Scale: 1" = 2000'

Contour Interval 10'

This location has been very carefully staked on the ground according to the best official survey records; maps, and photographs available to us, but its accuracy is not guaranteed.

Review this plat and notify us immediately of any possible discrepancy.

TOPOGRAPHIC ENGINEERING COMPANY

Surveying and Mapping for the Oil & Gas Industry

409 Regency Tower
 333 N.W. 5th St.
 Oklahoma City, Okla. 73102

Phone (405) 235-2363
 Outside Okla.-Direct Dial
 No Toll WATS (800) 654-3219

BEST IMAGE
 AVAILABLE