



00599467

TOPOGRAPHIC ENGINEERING COMPANY

Surveying and Mapping for the Oil & Gas Industry

409 Regency Tower 333 N.W. 5th St. (405) 235-2363
Oklahoma City, Okla. 73102

RECEIVED

JUN 20 1983

BEST IMAGE AVAILABLE


BACA County, Colorado

PRODUCTION OKC

2000' fSL-880' fEL Section 16 Township 35S Range 42W

RECEIVED

JUN 24 1983

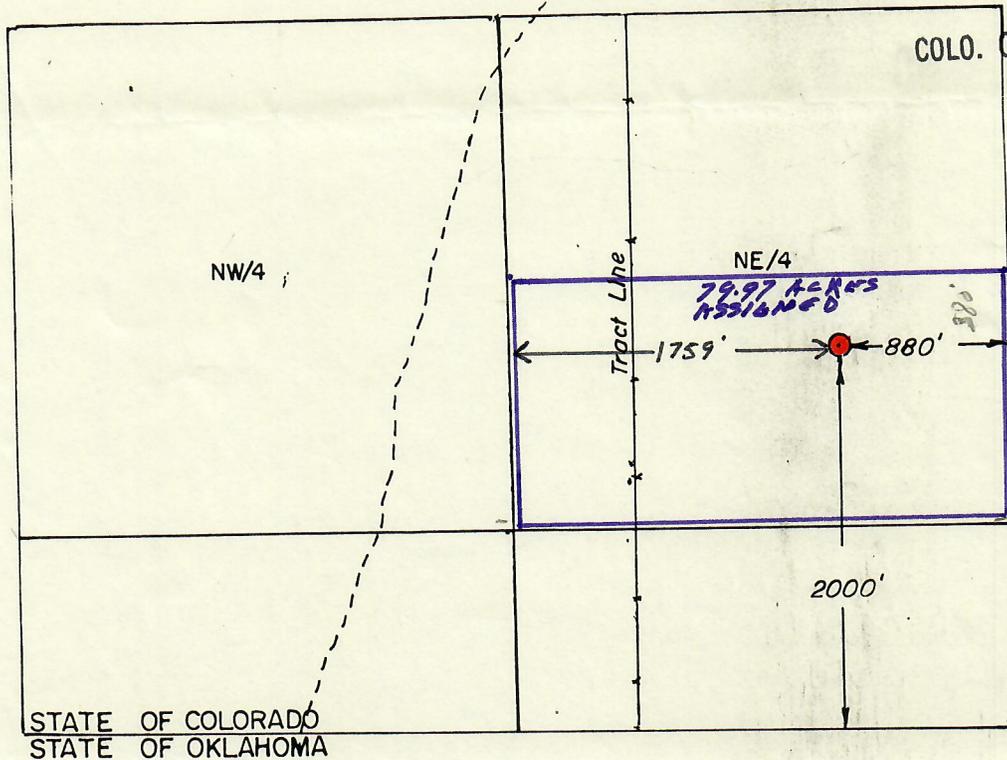

COLO. OIL & GAS CONS. COMM.

Scale: 1" = 1000'

Date Staked June 9, 1983

This location has been very carefully staked on the ground according to the best official survey records, maps, and photographs available to us, but its accuracy is not guaranteed.

Review this plat and notify us immediately of any possible discrepancy.

Operator: EDWIN L. COX

ELEVATION:
3758' Gr. at stake

Lease Name: State Daniels Well No.: 1

Topography & Vegetation Pasture

Good Drill Site? yes Reference Stakes or Alternate Location Stakes Set none

Best Accessibility to Location From South

Distance & Direction from Hwy Jct or Town From the Intersection of US 56 and SH 171, go NE on US 56, 5.5 miles; thence North 7.5 miles; thence follow trail NW to the SW Corner of tract 75 in section 16.

CERTIFICATE:

I, Douglas L. Carlson a Registered Land Surveyor and an authorized agent of Topographic Engineering Co., do hereby certify that the above described well location was surveyed and staked on the ground as shown herein.

Douglas L. Carlson

Reg. No. 20126

