




OIL AND GAS CONSERVATION COMMISSION OF THE STATE OF COLORADO

NOTICE OF INTENTION TO DRILL

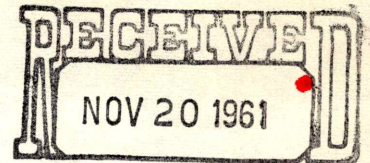

OIL & GAS
CONSERVATION COMMISSION

INSTRUCTIONS:

A notice of intention to drill a well shall be filed in duplicate on all Federal and Patented lands, and in triplicate on all State lands. Do not begin operations until approved copy has been received. It is mandatory that the proposed location comply with all rules and regulations of the Commission. Locate well on section grid in proper location, and indicate extent of lease. Unless operations are commenced within 180 days after the date of approval hereof, this approval to drill will become null and void.

Name of Operator Petroleum, Inc. Phone No. AC 2-9429
Address 860 Petroleum Club Bldg. City Denver 2 State Colorado


How is liability secured: Well Bond (Attached) ☒; Blanket Bond ☐; Waiver ☐
(Check one)

Lease Name MILLER-GILLHAM

Well No. 1

Field Name Wildcat ☒

County Logan

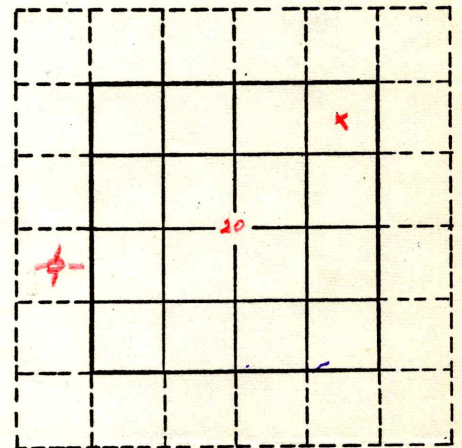

Location C NE NE Section 20 Township 10 N Range 52W Meridian 6th P.
(quarter quarter)
660 feet from North Section line and 660 feet from East Section Line
N or S E or W

The well is located on: Patented land ☒ State land ☐ Federal land ☐

The well is located within a spaced area: Yes ☐ No ☒

Distance from proposed location to nearest property or lease line 660 feet.

Distance from proposed location to nearest drilling unit line _____ feet.

Objectives: 10' Depth 5250 feet; _____ Depth _____
Formation Estimate Formation Estimate

Proposed length of surface casing 200 feet.

REMARKS:

8-5/8" casing at 200' w/150 sacks cement.



Agent	<u>OK</u>
Bond	<u>waiver</u>
Plot	<u>Plotted 11-20-61</u>
600 ft.	<input checked="" type="checkbox"/>
1200 ft.	<input type="checkbox"/>
Well	<input type="checkbox"/>
Cut	<input type="checkbox"/>
Gas	<input type="checkbox"/>
Status	<input type="checkbox"/>

I/We hereby swear (or affirm) that the statements herein made are a full and correct report.

APPROVED:

Date NOV 20 1961

Company PETROLEUM, INC. Date 11-17-61

Address 860 Petroleum Club Bldg. Phone No. AC 2-9429

By Richard J. Feiler Title Attorney in Fact
Signature

Director