

PETROLERO CORP #1-58 C.F.E.I

RECEIVED

FEB 13 1981

WELL
FILE

COLORADO OIL & GAS CONS. CO., INC.

DEVIATION

1 2 3 4 5 6 7 8 9 10

15
ft



00563578

200

12 1/4"

8 5/8 @ 350'

400

600

800

XXXXXXXX VOLCANIC SILL

1000

1200

1400

1600

1800

2000

2200

2400

Depth

DEVI

60

3/4°

90

1/2°

121

1/2°

181

1/2°

231

1/2°

341

3/4°

12 1/4

90

1/2°

211

3/4°

350

1°

426

1/2°

529

1/2°

580

1°

620

3/4°

702

1 1/4°

806

2°

865

3°

884

3°

922

3°

953

2 1/2°

1054

3°

1147

3 3/4°

1177

3 3/4°

1272

3 1/4°

1343

3 1/4°

1469

4°

1563

3 1/2°

1608

3 3/4°

1700

4°

1793

3 1/2°

1886

4 3/4°

1948

4 1/2°

1949

5°

2081

5 3/4°

2135

6°

2196

6°

2321

5° (12)

2413

5°

2506

3 1/2°

2600

2 1/4°

2692

1°

2857

1°

2943

1°

3064

1°

3159

6°

3190


7°

3284

6°

BEST IMAGE
AVAILABLE

1200
1400
1600
1800
2000
2200
2400
2600
2800
3000
3200
3400

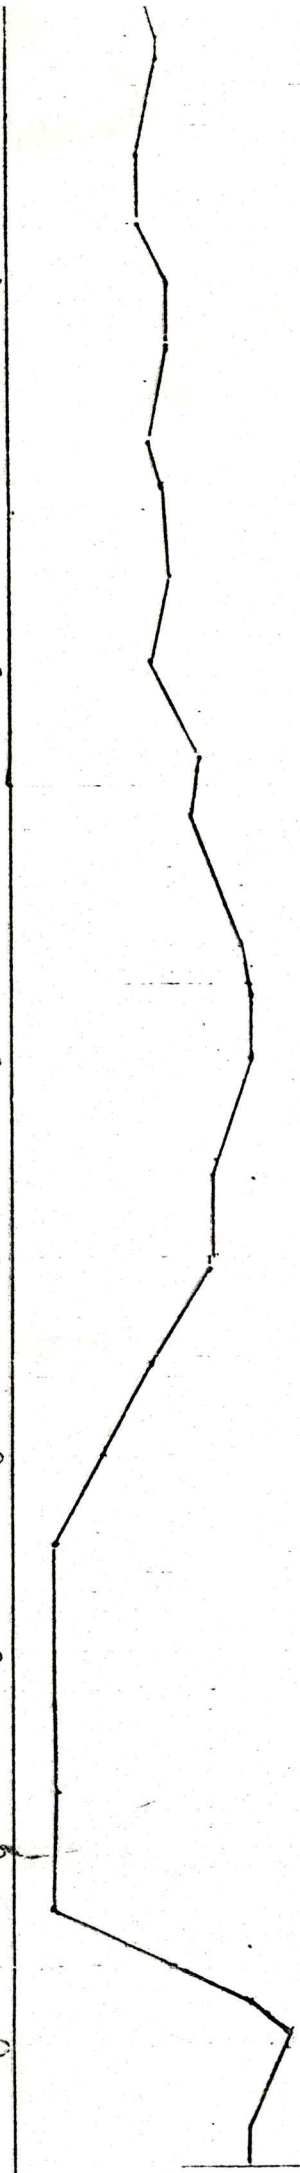

TD - 3524

1343	3 1/4'
1469	4'
1563	3 1/2'
1608	3 3/4'
1700	4'
1793	3 1/2'
1886	4 3/4'
1948	4 1/2'
1949	5'
2081	5 3/4'
2135	6'
2196	6'
2321	5' (14)
2413	5'
2506	3 1/2'
2600	2 1/4'
2692	1'
2857	1'
2943	1'
3064	1'
3159	6'
3190	7'
3284	6'