


**Well Name: STATE BERNHARDT 36-12**

VERTICAL, ORIGINAL HOLE, 5/24/2019 12:27:42 PM

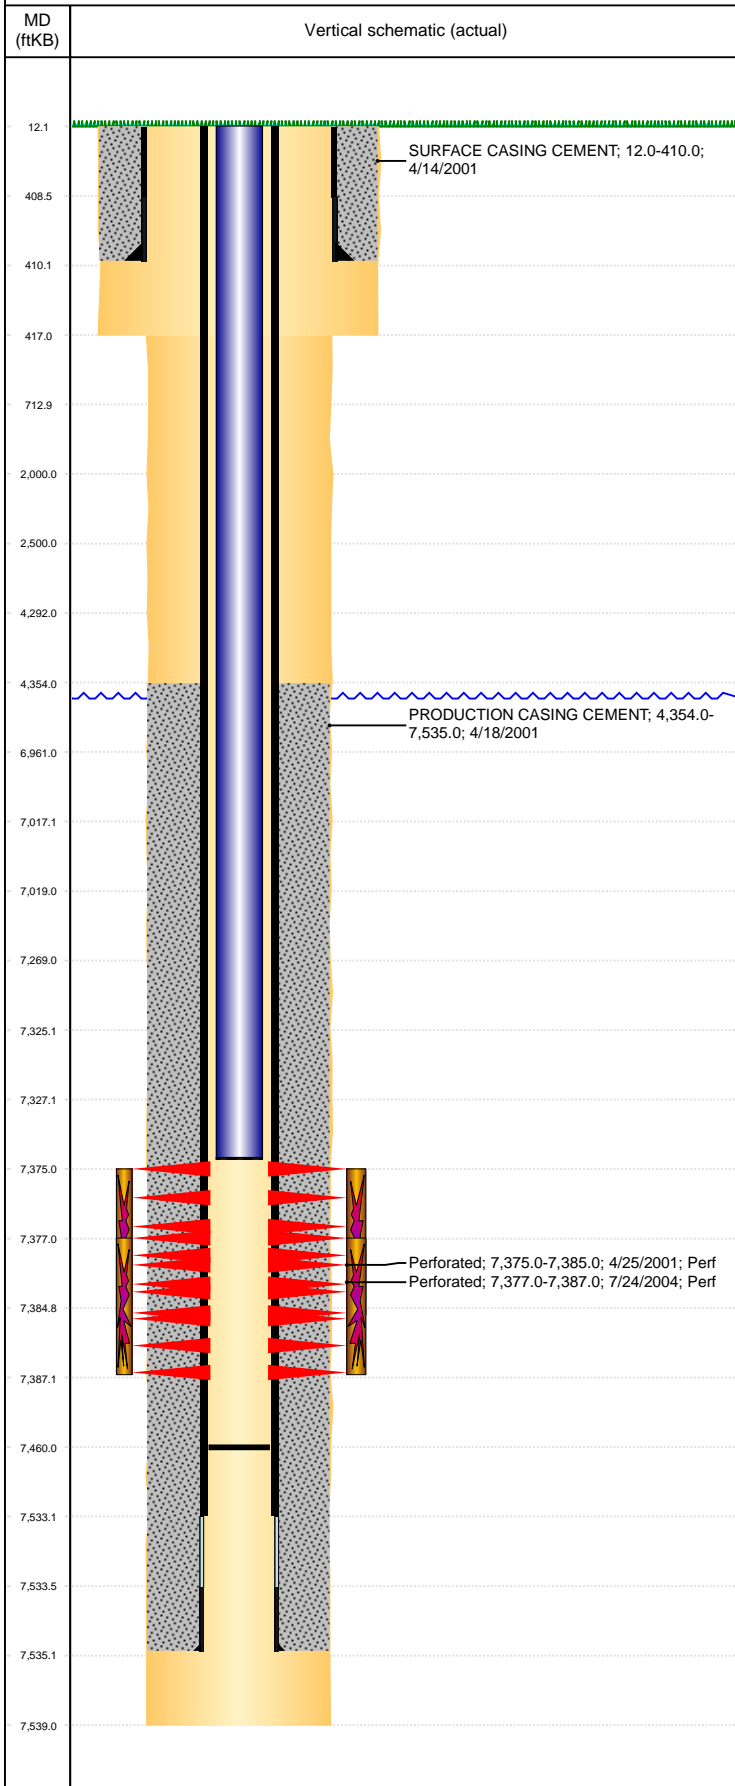

Well Header									
API 05-123-20317		Business Unit DJ BASIN			District 15		Well Config VERTICAL		
KB - GL / MSL (ft... 12.00		Spud Date 4/14/2001		P & A Date		Well Production Status PR			SoRT No
Comment									
Surface Location (Congressional)									
Qtr 3 NW	Qtr 4 NE	Section 36	Twnshp 5	Twnsh... N	Range 67	Rng E/... W	Actual Latitude (°) 40.36176500		Actual Longitude (°) -104.83937700
Wellbore Sections									
Section Des			Size (in)			Act Top, MD (ftKB)		Act Btm, MD (ftKB)	
SURFACE			12 1/4			12		417	
PRODUCTION			7 7/8			417		7,539	
Casing Strings									
Csg Des		Run Date		OD (in)	Wt/Len (lb/ft)	Grade	Top, MD (ftKB)	MD (ftKB)	
Surface		4/14/2001		8 5/8	24.00		12.0	410.0	
Production		4/18/2001		3 1/2	9.30	J-55	12.0	7,535.0	
Cement									
Des				Start Date		Top (ftKB)		Btm (ftKB)	
SURFACE CASING CEMENT				4/14/2001		12.0		410.0	
PRODUCTION CASING CEMENT				4/18/2001		4,354.0		7,535.0	
Zone Statuses									
Zone Name	Status Date	Status	Fluid Type	Job				Prod Method	
CODELL	5/7/2010	PR	Water	RE-FRAC, 7/26/2004 00:00				Flowing	
CODELL	7/30/3002	PR	Flowing						
Perforation Data									
Linked Zone		Bnch/Stg	Entered Shot Total	Top (ftKB)		Btm (ftKB)		Date	
CODELL, ORIGINAL HOLE			40	7,375.00		7,385.00		4/25/2001	
CODELL, ORIGINAL HOLE			40	7,377.00		7,387.00		7/24/2004	
Stimulation Intervals									
Zone			Start Date			Top (ftKB)		Btm (ftKB)	
CODELL, ORIGINAL HOLE			4/27/2001			7,375.0		7,385.0	
CODELL, ORIGINAL HOLE			7/26/2004			7,377.0		7,387.0	
Other In Hole									
Run Date		Des				OD (in)	Top (ftKB)	Btm (ftKB)	
Logs									
Date		Type				Top, MD (ftKB)		Btm, MD (ftKB)	
4/19/2001		COMPENSATED DENSITY				4,300.0		7,520.0	
4/19/2001		INDUCTION				410.0		7,540.0	
4/24/2001		CBL/CCL/GR				4,243.0		7,383.0	
Plug Back Total Depths									
Date		Type		Com				Depth (ftKB)	
4/24/2001		FILL		DEPTH LOGGER				7,388.0	
7/30/2004		FILL		CLEAN OUT TO SAND 7460'				7,460.0	