


**DRAFT**  
FINAL QC NOT COMPLETED

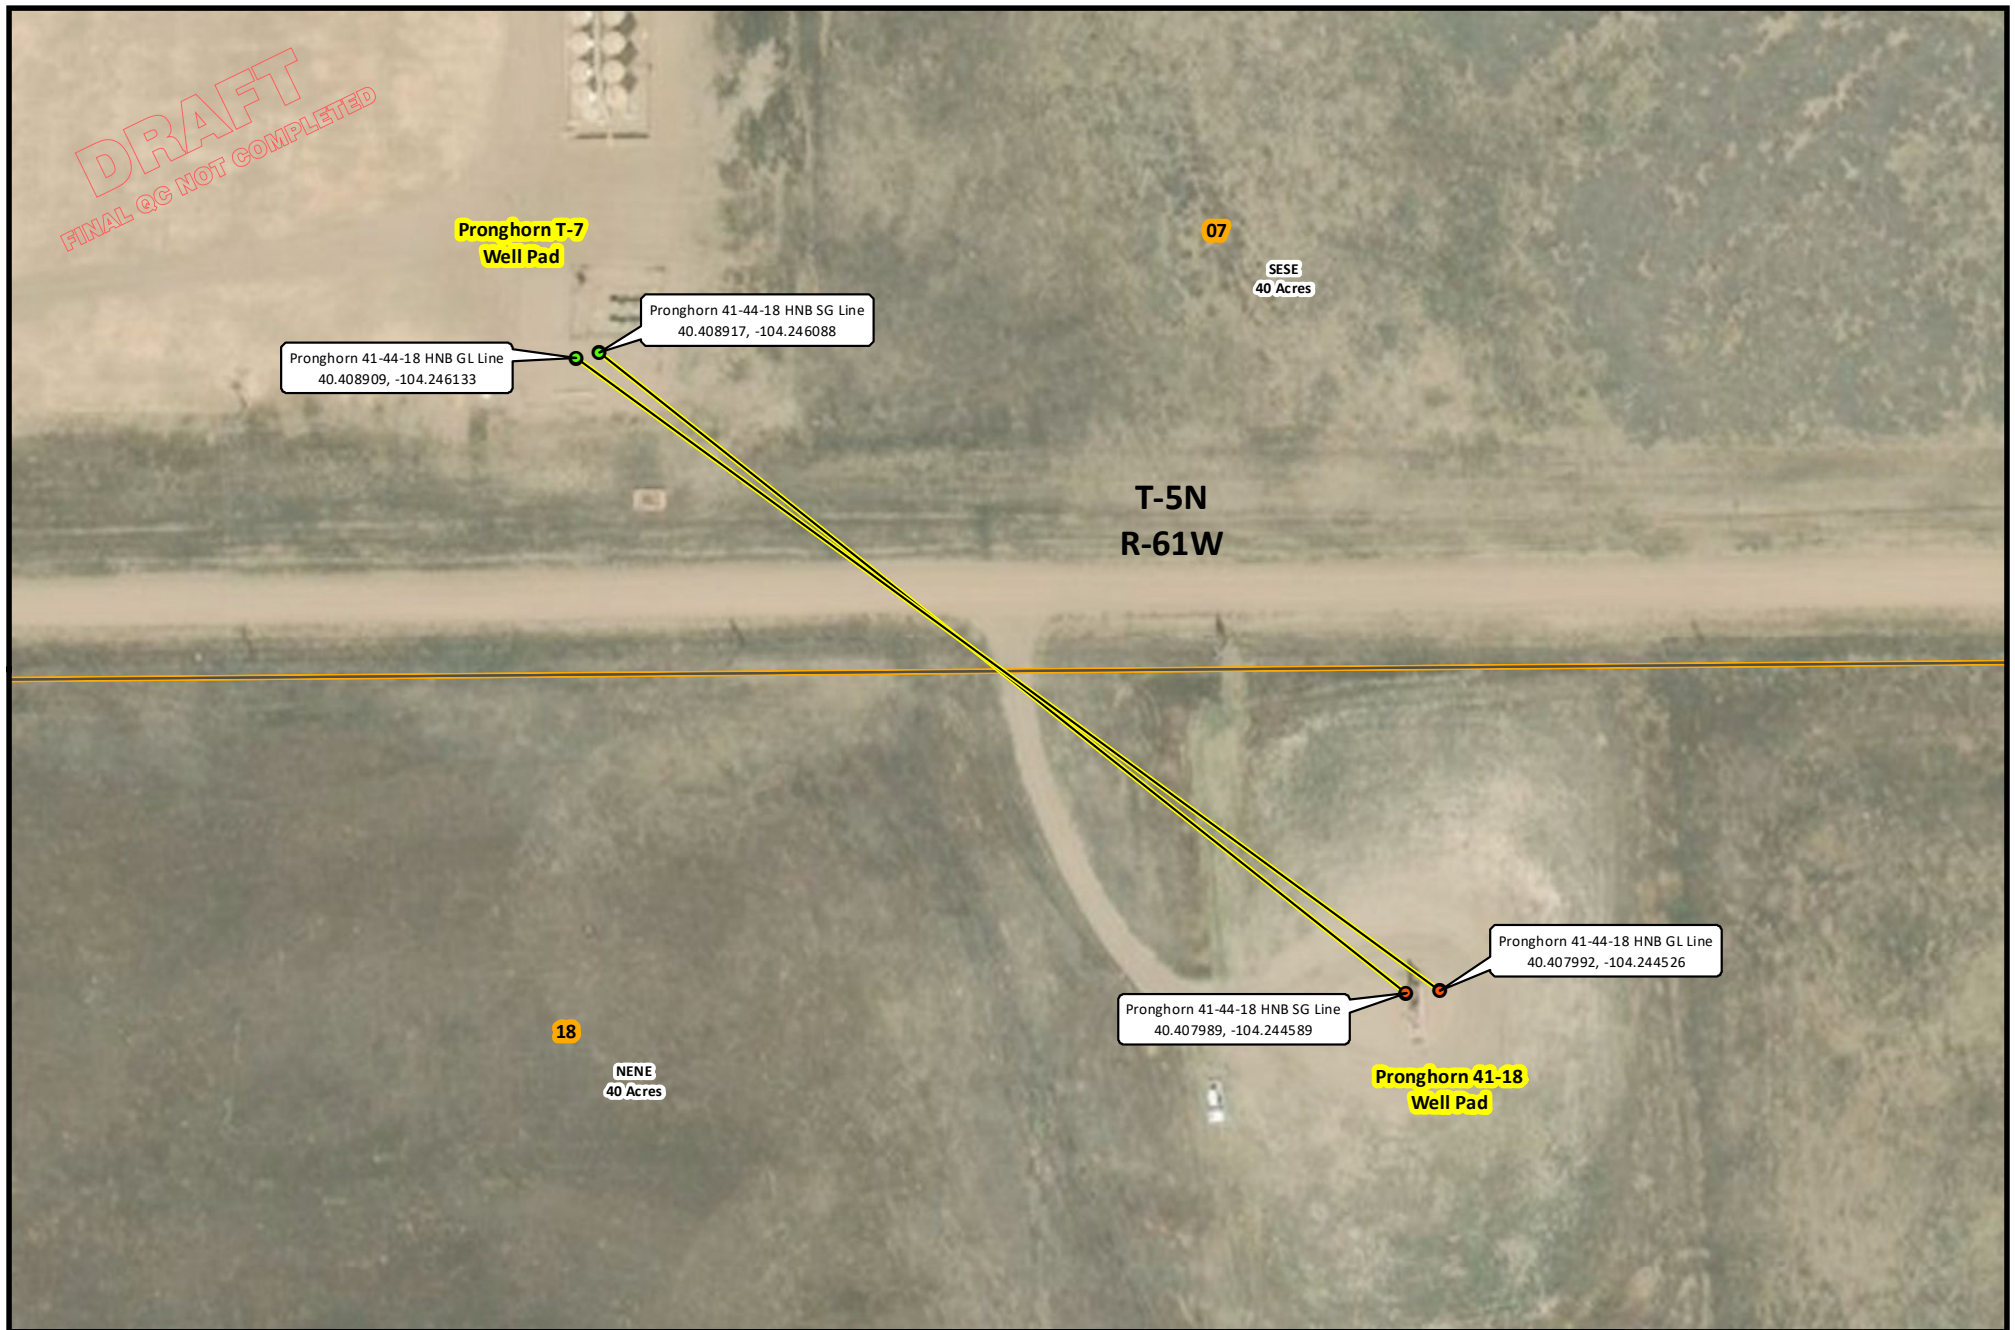


**Bonanza Creek**  
**PRONGHORN T-7 TO PRONGHORN 41-18**  
**GAS LIFT AND SUPPLY GAS LINES**  
**Off-Location Flowline Layout Drawing**  
Weld County, Colorado  
Project No. 102442007

5/20/2019

- Start Riser
- End Riser
- Off-Location Flowline

- PLSS Quarter Quarter
- PLSS Section

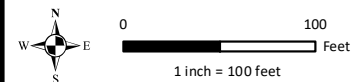

Service Layer Credits: Source: Esri, DigitalGlobe,  
GeoEye, Earthstar Geographics, CNES/Airbus DS, USDA,  
USGS, AeroGRID, IGN, and the GIS User Community

**BONANZA CREEK** **RETTEW**