

# Colorado Interstate Gas

LEASE: Flank # 35  
FIELD: Flank  
COUNTY: Baca  
STATE: Colorado  
LOCATION: 20 34S 42W  
API #: 05-009-05039-00  
SPUD: 03/20/62 [Original]  
SPUD: 06/19/83 [Re-Entry]  
Rev. Date 05/16/19 - APT

ELEVATION: GL: 3,695' [Re-Surveyed (04/29/83)]

KB: 3,704' [Post Re-Survey]


TD: 5,187' GL PBTD: 5,137' GL

TOC: 1,100' GL (Temp Survey - 06/21/83)

Perfs: 4,778' - 4,784' GL w/ 2 SPF

PBTD @ 5,137' GL

TD 7-7/8" hole @ 5,187' GL

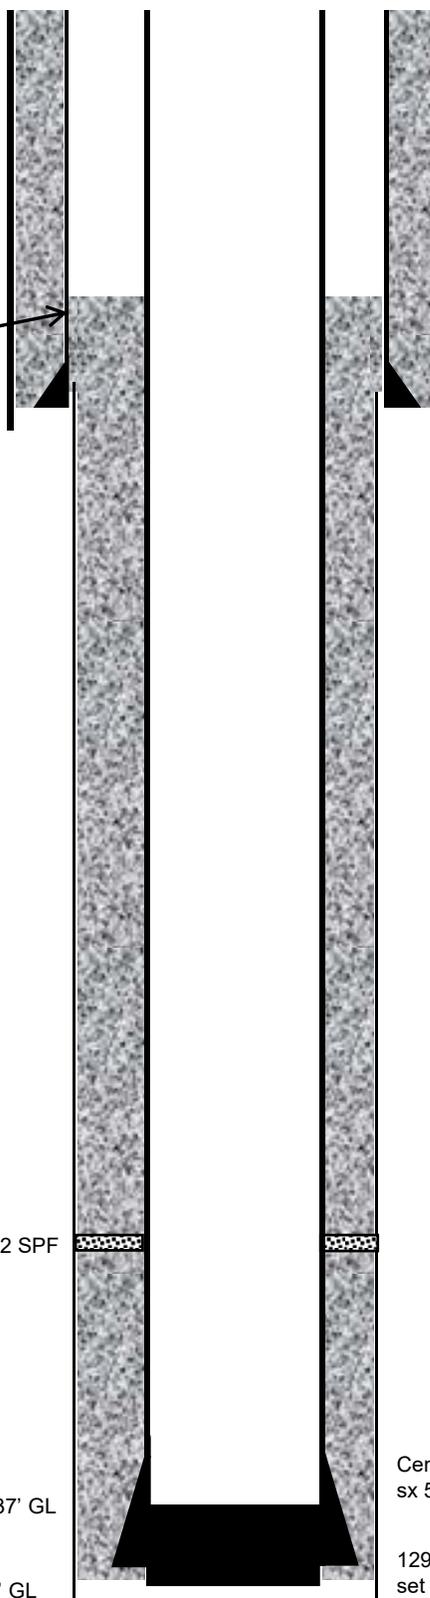

Cemented w/ 520 sx [No details provided by original operator]

8 5/8", 24#, Grade A casing @ 1,360' GL

TD 12-1/4" Surface hole @ 1,360' GL

Cement w/ 925 sx Hall. Light and 200 sx 50/50 poz. Cmt Did not Circ.

129 jts, 5-1/2", 15.5#, K55, 8R, LT&C csg set @ 5,180' GL