


Colorado Interstate Gas

LEASE: Flank # 32
FIELD: Flank
COUNTY: Baca
STATE: Colorado
LOCATION: 03 34S 42W
API #: 05-009-05069-00
SPUD: 05/05/63 [Original]
SPUD: 06/01/82 [Re-Entry]
Rev. Date 05/17/19 - APT

ELEVATION: GL: 3,702' [Re-Surveyed
(11/04/87)]

KB: 0

TD: 4,692' GL PBTD: 4,651' GL

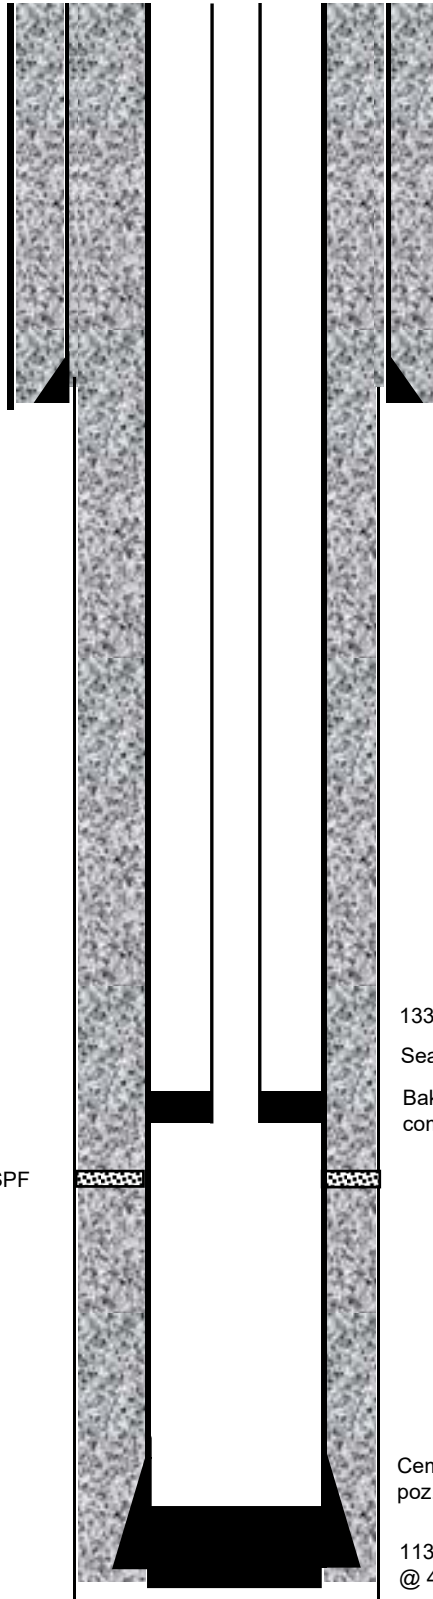

Cemented w/ 225 sx. [No details
provided by original operator.]
8 5/8", 28#, J-55 casing set at 317' GL

TD 12-1/4" Surface hole @ 318? GL

133 jts, 2-3/8", 4.7#, J55, 8R, EUE tbq

Seating nipple at 4,053' GL

Baker LOK-SET packer at 4,057' GL w/ 2,000#
compression and wire line entry guide on btm.

Perfs: 4,068' - 4,076' GL w/ 2 SPF

PBTD @ 4,651' GL

TD 7-7/8" hole @ 4,692' GL

Cement w/ 825 sx Hall. Light and 200 sx 50/50
poz. Cmt Circ.

113 jts, 5-1/2", 15.5#, K55, 8R, LT&C csg set
@ 4,684' GL