


Colorado Interstate Gas

LEASE: Flank # 29
FIELD: Flank
COUNTY: Baca
STATE: Colorado
LOCATION: 33 33S 42W
API #: 05-009-05077-00
SPUD: 04/11/63 [Original]
SPUD: 05/24/82 [Re-Entry]
Rev. Date 05/17/19 - APT

ELEVATION: GL: 3,811' [Re-Surveyed
(11/04/87)]

KB: 0

TD: 4,789' GL PBTD: 4,771' GL

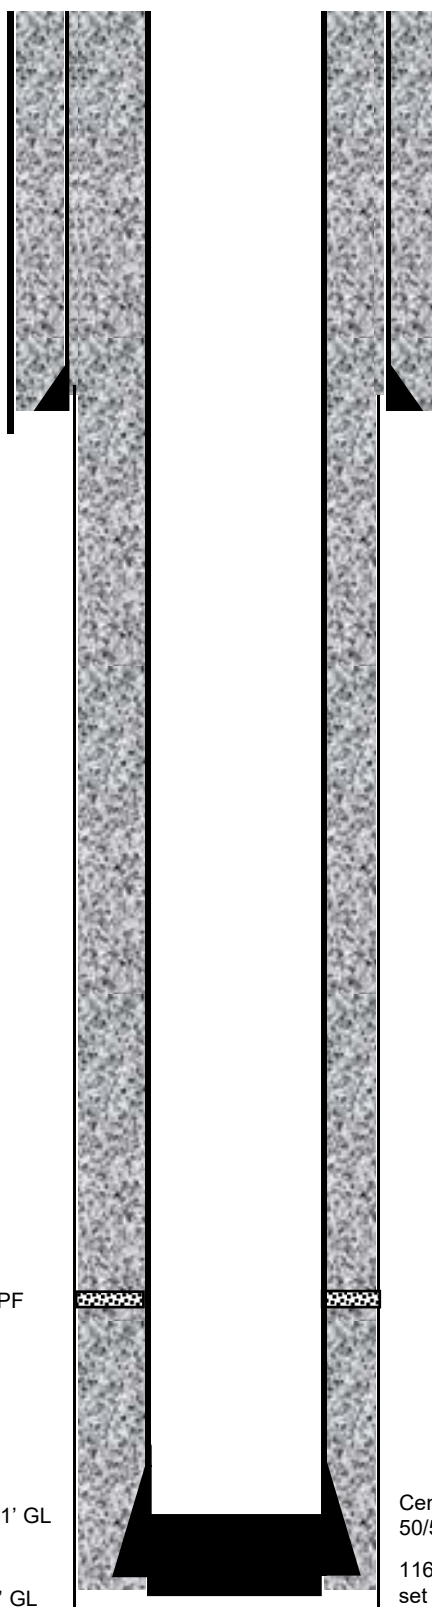

Cemented w/ 275 sx. [No details
available from original operator.]
8 5/8", 24#, J-55 casing set at 429' GL
TD 12-1/4" Surface hole @ 440' GL

Perfs: 4,745' - 4,755' GL w/ 2 SPF

PBTD @ 4,771' GL

TD 7-7/8" hole @ 4,789' GL

Cement w/ 825 sx Hall. Light and 200 sx
50/50 poz. Cmt Circ.

116 jts, 5-1/2", 15.5#, K55, 8R, LT&C csg
set @ 4,788' GL