

Colorado Interstate Gas


LEASE: Flank # 18
FIELD: Flank
COUNTY: Baca
STATE: Colorado
LOCATION: 18 34S 42W
API #: 05-009-05047-00
SPUD: 06/06/62 [Original]
SPUD: 09/15/81 [Re-Entry]
Rev. Date 05/23/19 - APT

ELEVATION: GL: 3,765' [Re-Surveyed
(10/20/81)]

KB = GL + 8'

TD: 4,817' GL PBTD: 4,192' GL

Holes in casing from 609' – 640' GL. Squeezed
w/ 320 sx. cement (09/16/81). Cmt. Circ.

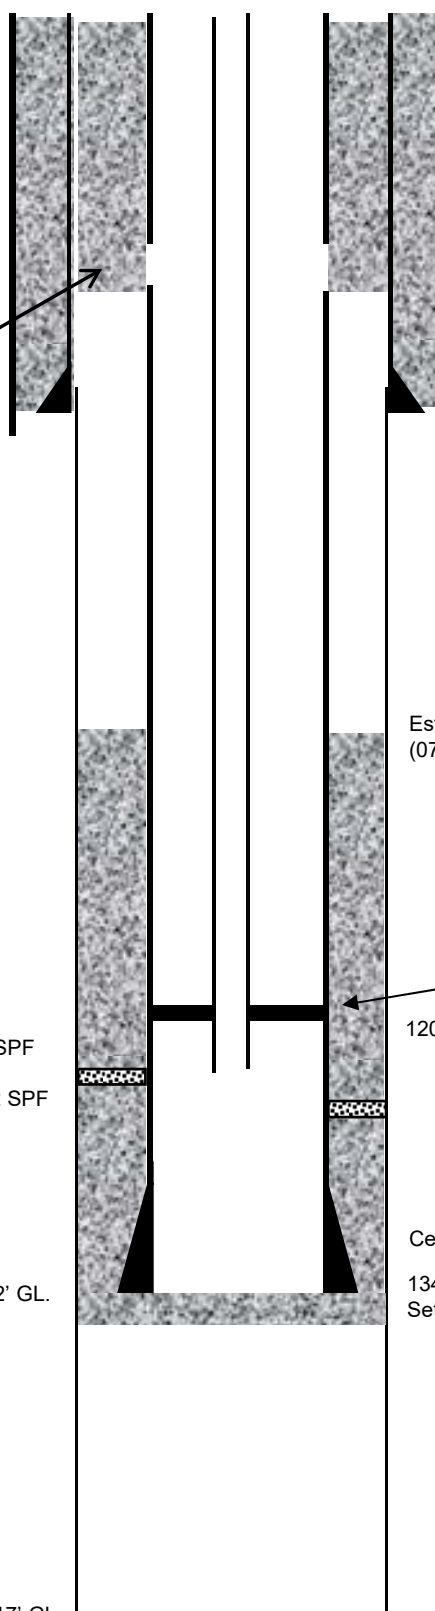

Cemented surface casing w/ 150 sx.
common & 410 sx. Poz. Cmt. Circ.

48 jts, 8 5/8", 24#, J-55, ST&C casing
set at 1,432' GL

TD Surface hole @ 1,432' GL, size
unknown

Est. TOC 2,400' from Temp. Survey
(07/01/62)

Baker Model C-1 packer set at 4,056' GL

120 jts, 1-1/4", 2.4#, J55 tbq set at 4,090' GL

Cement w/ 150 sx. Trinity Inferno

134 jts, 2-7/8", 6.5#, J55, 8R, EUE casing.
Set at 4,224' GL

Perfs: 4,090' – 4,096' GL w/ 2 SPF

Reperf: 4,090' – 4,096' GL w/ 2 SPF
(09/20/81)

PBTD @ 4,192' GL.

Original TD 7-7/8" hole @ 4,817' GL