


Colorado Interstate Gas

LEASE: Flank # 12
FIELD: Flank
COUNTY: Baca
STATE: Colorado
LOCATION: 7 34S 42W
API #: 05-009-05062-00
SPUD: 09/30/61 [Original]
SPUD: 07/01/80 [Re-Entry]
Rev. Date 05/30/19 - APT

ELEVATION: GL: 3,779' [Re-Surveyed (10/20/81)]

KB = GL + 9'

TD: 4,766' GL PBTD: 4,552' GL

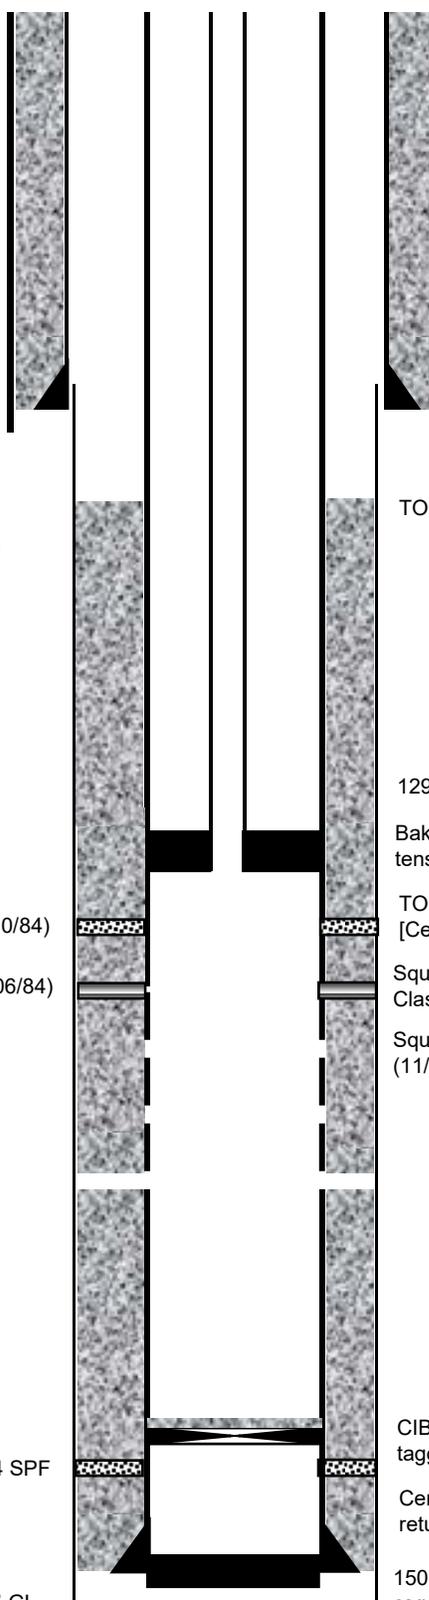

Cemented w/ 465 sx. poz & 100 sx. common. Cmt. circ.

55 jts, 8 5/8", 24#, J-55 casing set @ 1,435' GL

TD 12-1/4" Surface hole @ 1,436' GL

TOC unknown

Bad casing from 2,528' to 4,500', worst part from 2,528' to 2,945' (07/04/80).

Set retainer @ 2,440', RBP @ 4,576'. Cemented w/550 sx. Lost returns (07/08/80)

Sqzd. holes 2nd time w/ 400 sx. (07/09/80)

Sqzd. holes 3rd time w/ 200 sx. (07/15/80) w/pkr @ 2,422' GL

129 jts, 2-3/8", 4.7#, N80, 8R, EUE tubing.

Baker Lok-Set packer @ 4,031' GL w/ 7,000# tension.

TOC @ 4,049' GL – Original operator. [Cement Location Log (10/21/61)]

[Cherokee] Perfs: 4,083' – 4,093' w/ 4 SPF (11/10/84)

Perf 4 sqz. holes 4,117'–4,118' (11/06/84)

Squeezed 4,117'-4,118' w/ additional 100 sx. Class H (11/09/84). Squeezed off.

Squeezed 4,117'-4,118' w/ 100 sx. Class H (11/09/84). Did not squeeze off.

[Morrow] Perfs: 4,629' – 4,637' GL w/ 4 SPF (10/22/61)

CIBP @ 4,570' GL w/ 2 sx. cmt on top. Cmt tagged @ 4,552' GL (11/06/84)

Cement w/ 275 sx. common, lost returns during job

TD 7-7/8" hole @ 4,766' GL

150 jts, 5-1/2", 15.5#, J55, 8R, ST&C csg set @ 4,761' GL