



00255448

MT HOPE GREEN #2
NE SE 24 T9N R56W


	QTR	QTR	SEC	TWNS	RANGE	PM	NAME	DEPTH	TPERF	BPERF
A	NE	SW	08	090N	0540W	S	BUCHLEITER R			
B	SE	NW	09	090N	0540W	S	BUCHLEITER ROY	460		
C	SE	SE	10	090N	0540W	S	RIEKE LOUIE	460		
D	SW	SW	12	090N	0540W	S	SVACINA JIM JR	46		
E	NE	NE	14	090N	0540W	S	SVACINA JAMES			
F	NE	NE	14	090N	0540W	S	SVACINA JAMES JR.	82		
G	NW	NW	15	090N	0540W	S	GONYEA DAVID L	520	255	515
H	NW	NE	16	090N	0540W	S	COLO STATE BOARD LAND COMM	54		
I	SE	NE	22	090N	0540W	S	WILSON HAROLD	113		
J	SE	SE	24	090N	0540W	S	TEXACO INC	412		
K	SE	SE	25	090N	0540W	S	SHELL OIL COMPANY	632		
L	NE	SW	26	090N	0540W	S	KESTER LEWIS H	600		
M	NE	SE	27	090N	0540W	S	BANEY ROBERT	574		
N	SE	NE	32	090N	0540W	S	LUFT ALBERT E.	80		
O	SW	SE	32	090N	0540W	S	RIEKE LLOYD			
P	NE	NW	33	090N	0540W	S	KOENIG V C	55		
Q	SW	NE	34	090N	0540W	S	WALTERS KATHERINE ESTATE	240		
R	SW	NE	34	090N	0540W	S	WALTERS KATHERINE ESTATE	200	100	200
S	SW	SE	34	090N	0540W	S	KOENIG MILDRED H & V C			
T	SE	NW	36	090N	0540W	S	CO BRD LND COMMISSIONERS	600		

Letter=Choice | F10=Mark 1 | PgUp/PgDn=±20 | UpAr/DnAr =±1 | Esc=Quit

0 = WATER WELL

OIL AND GAS WELL/WATER WELL

BASE PLAT

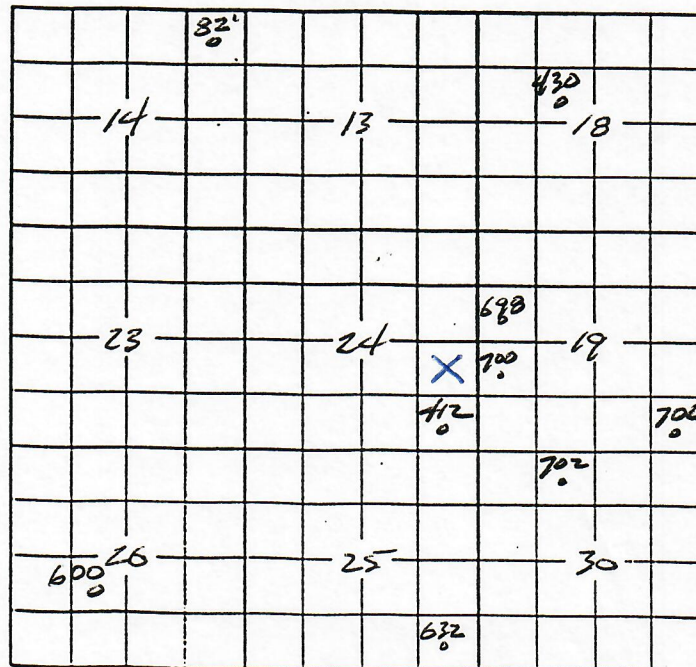

SCHLUMBERGER

WELL SURVEYING CORPORATION

Location of Well	COMPANY...THE TEXAS CO.....	COUNTY...LOGAN
NE NE SE	WELL...C.F.A. GREEN #A-7.....	FIELD OR MOUNT HOPE
E.S. 13000	FIELD...MOUNT HOPE.....	LOCATION SEC. 24-9N-54W
Elevation D.F. 4166	LOCATION SEC. 24-9N-54W	WELL C.F.A. GREEN #A-7
K.A. 4190	COUNTY...LOGAN.....	COMPANY THE TEXAS CO.
or G.L.	STATE...COLORADO.....	
	FILING No. D-2380	

RUN NO.	ONE			
Date	10/23/51			
First Reading	5045			
Last Reading	173			
Footage Measured	4820			
Cog Shoe Schlum.	73			
Cog Shoe Driller	74			
Max. Depth Reached	5050			
Bottom Driller	808			
Depth Datum				
Mud Nature				
" Density	9.8			
" Viscosity	50			
" Resistivity	4.0 @ 65. F			
" Resistivity BHT				
" pH				
" Water Loss	CC/30 Min	CC/30 Min	CC/30 Min	CC/30 Min
Maximum Temp. °F	97.8 W			
Bit Size	15 1/8"			
Spacings - AM	15'			
A M	62'			
AO	15' 8"			
E.S. Rig Time	2 HOURS			
Truck No.	791-SID			
Recorded By	JOHNSON			
Witnessed By	OLSON			

REMARKS

MUD SAMPLE TAKEN FROM FLOW LINE.

A RILEY REPRODUCTION

Reg. No. 579992

SPONTANEOUS-POTENTIAL millivolts	DEPTH feet	RESISTIVITY -ohms. m ² /m.
-------------------------------------	---------------	--

4889
4190
689

4002
4190
- 802

- 20 +

NORMAL

570

LONG NORMAL

50

0 LATERAL 50

0 AMPLIFIED NORMAL 10

CSG.
175

