


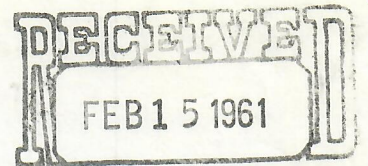

00275538

OIL AND GAS CONSERVATION COMMISSION  
OF THE STATE OF COLORADOOIL & GAS  
CONSERVATION COMMISSION

## NOTICE OF INTENTION TO DRILL

## INSTRUCTIONS:

A notice of intention to drill a well shall be filed in duplicate on all Federal and Patented lands, and in triplicate on all State lands. Do not begin operations until approved copy has been received. It is mandatory that the proposed location comply with all rules and regulations of the Commission. Locate well on section grid in proper location, and indicate extent of lease. Unless operations are commenced within 180 days after the date of approval hereof, this approval to drill will become null and void.

Name of Operator Sinclair Oil & Gas Company Phone No. AMherst 6-2460  
Address 601 Denver Club Building City Denver 2, State Colorado


How is liability secured: Well Bond (Attached) ☐; Blanket Bond ☒; Waiver ☐  
(Check one)

Lease Name Arthur Sindt

Well No. 6

Field Name West Padroni Wildcat ☐

County Logan

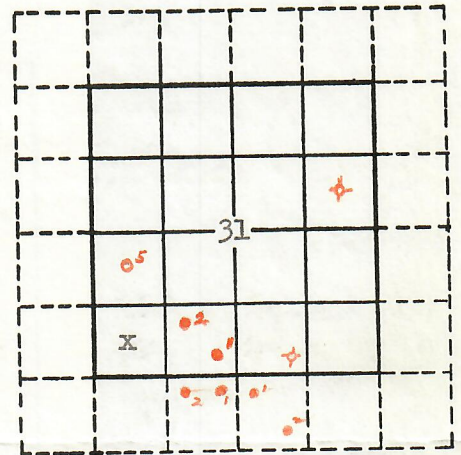

Location SW/4 SW/4 Section 31 Township 10N Range 52W Meridian 6<sup>th</sup> P.M.  
(quarter quarter)  
660 feet from S Section line and 660 feet from W Section Line  
N or S E or W

The well is located on: Patented land ☒ State land ☐ Federal land ☐

The well is located within a spaced area: Yes ☒ No ☒

Distance from proposed location to nearest property or lease line 660 feet.  
Distance from proposed location to nearest drilling unit line \_\_\_\_\_ feet.

Objectives: Dakota Formation Depth 5175 Estimate; \_\_\_\_\_ Formation Depth \_\_\_\_\_ Estimate

Proposed length of surface casing 200 feet.

REMARKS:

Agent	
Bond	<u>waived</u>
Spot	<u>Plotted 2/15/61</u>
600 ft.	
1200 ft.	
Wells	
Oil	
Gas	
Status	

I/We hereby swear (or affirm) that the statements herein made are a full and correct report.

APPROVED:

Date Feb 15 1961

Director

Company Sinclair Oil & Gas Co. Date 2-10-61  
601 Denver Club Building  
Address Denver 2, Colorado Phone No. AM 6-2460  
Asst. Div. Prod.  
By Ford H. Harkins Title Superintendent  
Signature



Oil & Gas  
Conservation Commission  
FEB 15 1961

NOTICE OF INTENTION TO DRILL  
OIL AND GAS CONSERVATION COMMISSION  
OF THE STATE OF COLORADO

INSTRUCTIONS:

A notice of intention to drill a well shall be filed in duplicate on all Federal and Patented lands, and in triplicate on all State lands. Do not begin operations until approved copy has been received. It is mandatory that the proposed location comply with all rules and regulations of the Commission. Locate well on section grid in proper location, and indicate extent of lease. Unless operations are commenced within 180 days after the date of approval hereof, this approval to drill will be void.

How is liability secured: Well Bond (Attached) ☐ Blanket Bond ☐ Waiver ☐  
Address: 601 Denver Club Building  
City: Denver 2 State: Colorado Phone No: AM 6-2460

To Lina  
Date 2-6 Time 10:26

WHILE YOU WERE OUT

Name Jim Onisko  
of Acad  
Phone 293-1060

Telephoned		Please Call	<input checked="" type="checkbox"/>
Returned your call		Will Call Again	<input checked="" type="checkbox"/>
Wants To See You		RUSH	<input type="checkbox"/>

Message Mela Tidwell  
Foreman  
3 7/8" fish tail bit  
John  
OPERATOR

395-51-06-0013 Printed By Division of Central Services

I/We hereby swear (or affirm) that the statements herein made are a full and correct report.


APPROVED:

Date