


Well/Facility: Little Beaver Unit #36 Well Status: SI
 Operator: Magpie Operating Inc Formation: DSND
 Lease/Op Agmt: _____ Prod Interval: 5,253' - 5,273'
 Field: Little Beaver API #: 05-121-06232
 County: Washington GR/KB: 4,645'
 State: CO TD: 5,331'
 Spud: 5/2/1953 PBTD: 5,324'
 Comp. Date: 5/18/1953 WI: _____
 1st Prod: 5/18/1953 NRI: _____
 Xmas tree: _____
 Surface Loc: 330 FSL 990 FEL
 Sec-Twn-Rge: SESE 31 1S56W
 Comments: Current Well Diagram

Date Drawn: 6/5/19

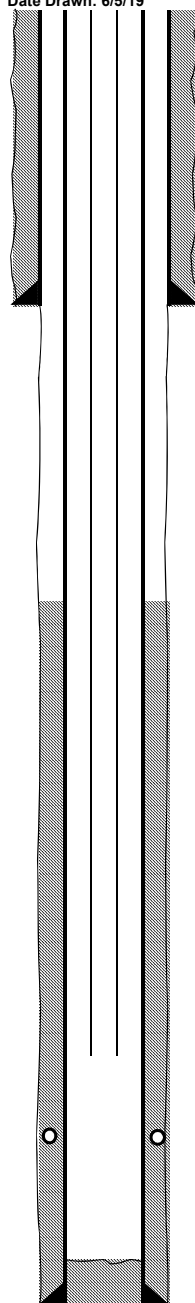

Hole Size
12-1/4"

 Surface Csg @ 99'
8-5/8", 24#
Cement to surface 75 sx

Hole Size
7-7/8"

2-1/2" Tubing to 5,218'

Perfs - DSND
5,253'-5,273'
96 Holes

Prod Csg @ 5,324'
5-1/2", 15.5#
260 sx cement TOC = 3,283' (est)

Gologic Markers	
MD	
4,382'	Niobrara
4,839'	Carlile
5,223'	D Sand
5,299'	J Sand