



Whiting Oil & Gas Corporation

Off-Location Flowline Layout Drawing


SW/NW Section 11 T10N R58W 6th P.M.

Flowline End Point Location: Razor 11E Pad - Location ID: 435245


Flowline Start Point Location: Razor 11 Production CPB – Location ID: 436611



Legend	
	Off-Location Flowline
	Flowline Start Point
	Flowline End Point

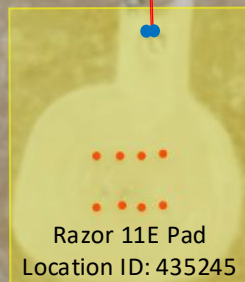

Razor 11E Pad
Location ID: 435245

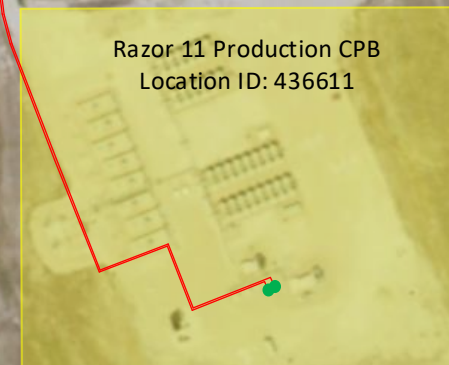

Razor 11 Production CPB
Location ID: 436611

- Razor 11E Pad
End Points
- North Gas Lift Line
 - South Gas Lift Line

- Razor 11 Production CPB
Start Points
- Razor 11E North Gas Lift Line
 - Razor 11E South Gas Lift Line

0 100 200 ft