


Colorado Interstate Gas

LEASE: Flank # 5
FIELD: Flank
COUNTY: Baca
STATE: Colorado
LOCATION: 8 34S 42W
API #: 05-009-05061-00
SPUD: 07/08/63 [Original]
SPUD: 08/03/79 [Re-Entry]
Rev. Date 06/05/19 - APT

ELEVATION: GL: 3,737'

KB = GL + 11'

TD: 4,739' GL PBTD: 4,701' GL

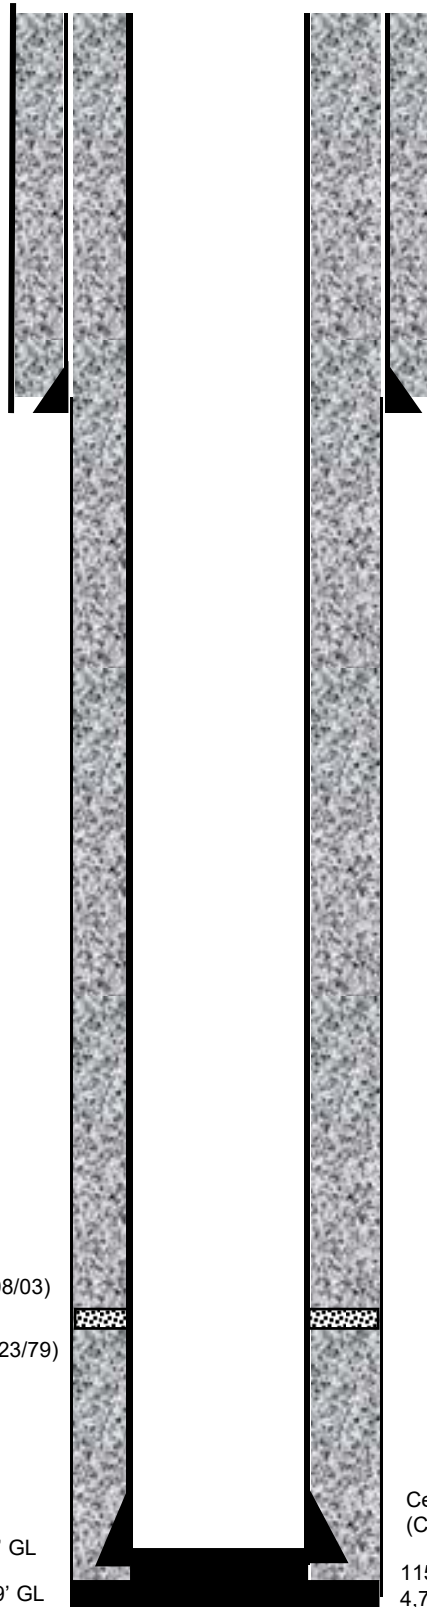

Cemented surface w/ 525 sx. Common.
8 5/8", 24#, J55, 8R casing @ 619' GL
Depth and size of surface hole unknown

Perfs: 4,033'-4,055' GL w/ 4 SPF (07/08/03)

Perfs: 4,035'-4,052' GL w/ 2 SPF (08/23/79)

PBTD @ 4,701' GL

TD 7-7/8" hole @ 4,739' GL

Cemented w/ 1,025 sx. HLC & 200 sx. 50/50 poz.
(Cmt. Circ.)

115 jts, 5-1/2", 15.5#, K55, 8R casing set @
4,723' GL