



01131978

RECEIVED

NOV 18 04

COGCC


WELL LOCATION CERTIFICATE

SECTION 9, TOWNSHIP 4 NORTH, RANGE 64 WEST, 6TH P.M.

NW SEC. 9
2.5° AC PLS 19585

N 1/4 SEC 9
2.5° AC PLS 23501

BASIS OF BEARINGS

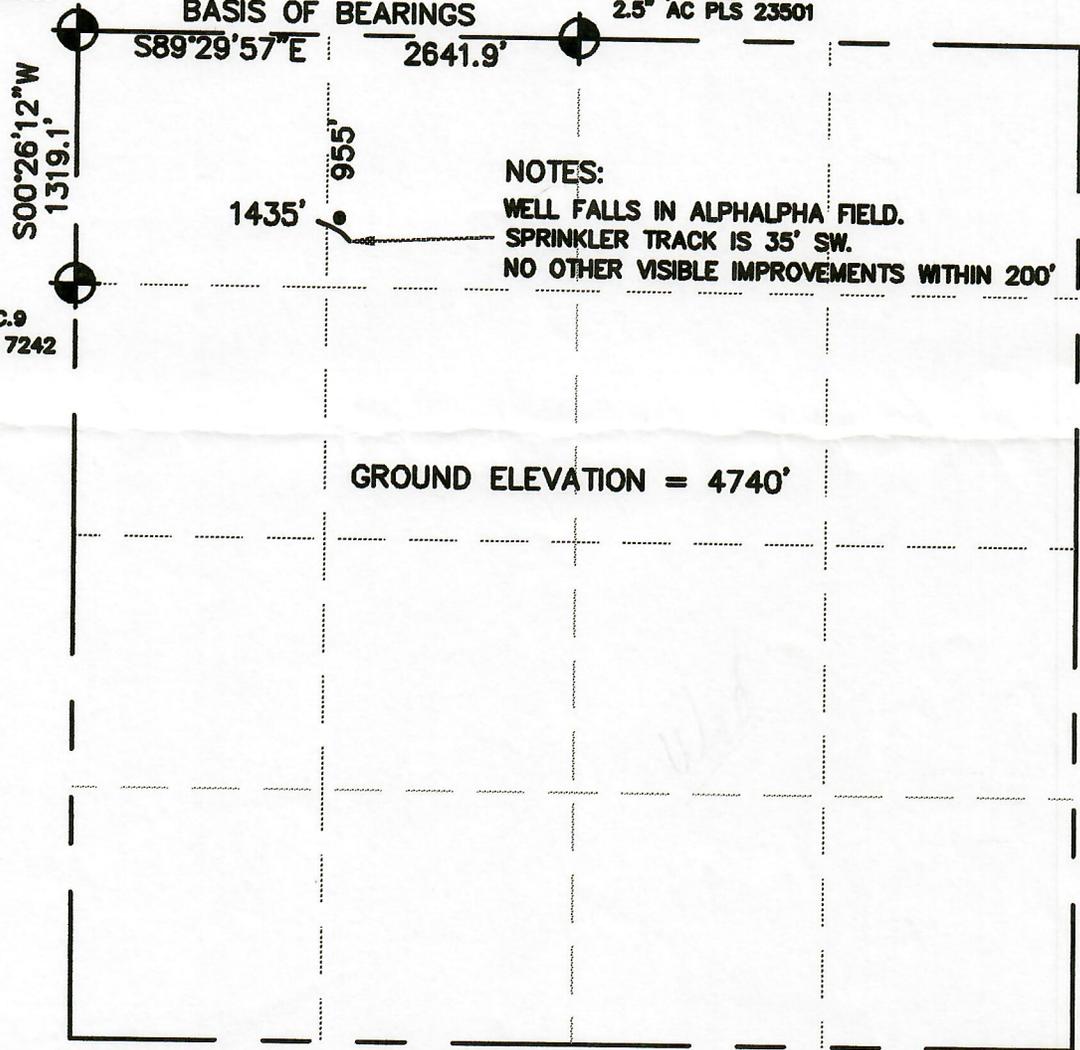

NOTES:
 WELL FALLS IN ALPHALPHA FIELD.
 SPRINKLER TRACK IS 35' SW.
 NO OTHER VISIBLE IMPROVEMENTS WITHIN 200'




GROUND ELEVATION = 4740'

I HEREBY STATE TO PATINA OIL & GAS THAT THIS WELL LOCATION CERTIFICATE
 FOR THE WELL SMITH C9-19 IS LOCATED 955' FNL & 1435' FWL, SEC. 9, T4N, R64W, 6PM.



LEGEND

- FOUND MONUMENT
- PROPOSED WELL
- IMPROVEMENTS (AS LABELED)

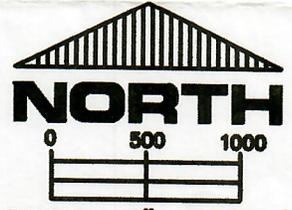

SCALE 1" = 1000'

ELEVATION SOURCE - USGS 7.5' QUAD.MAP CONTOURS NGVD 1929 DATUM

DISTANCES ARE FIELD MEASURED

DISTANCES TO WELL SHOWN PERPENDICULAR TO SECTION LINES

LAT. & LONG. ARE APPROXIMATE VALUES ONLY

THOMAS G. CARLSON, PLS 24657
 HORSESHOE SURVEYING, LLC

THIS IS NOT A MONUMENTED BOUNDARY SURVEY, IT IS
 ONLY INTENDED TO DEPICT THE WELL LOCATION TO SECTION LINES.

PREPARED BY: HORSESHOE SURVEYING, LLC PO BOX 150458 LAKEWOOD CO 80215 (720)872-0196		WELL NAME: SMITH C9-19	
DRAWING DATE: 11-1-04		LOCATION: WELD COUNTY, CO NW1/4, SEC. 9, T4N, R64W, 6TH P.M.	
FIELD DATE: 11-1-04	BY: TGC	CHKD:	JOB NO. SHEET NO.