




WELL LOCATION CERTIFICATE


WELLS RANCH STATE AA32-745

SECTION: 5
TOWNSHIP: 5N
RANGE: 63W
6TH. P.M.
WELD COUNTY, CO

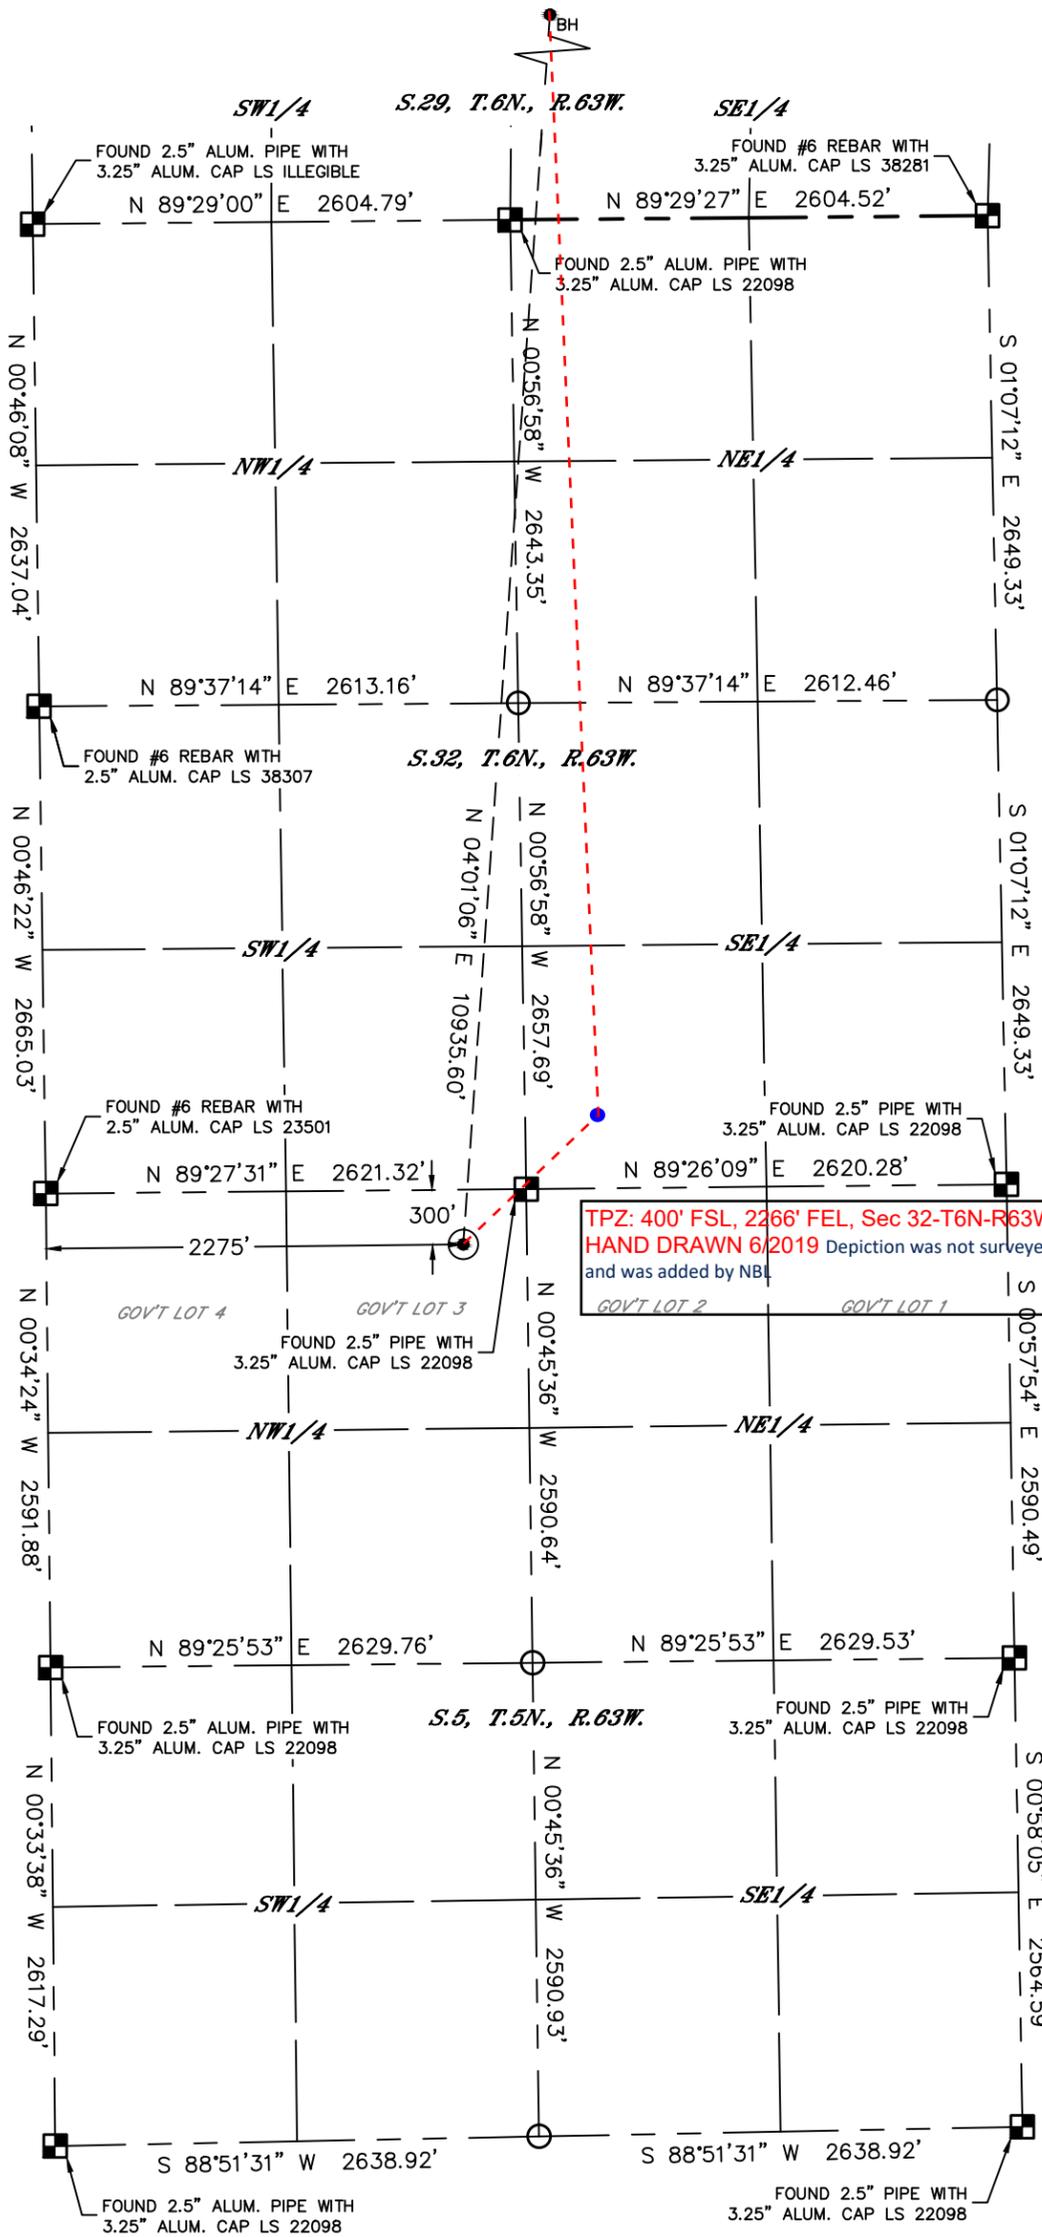

APPROVED
By Cory at 3:21 pm, Jun 05, 2019

TPZ: 400' FSL, 2266' FEL, Sec 32-T6N-R63W
HAND DRAWN 6/2019 Depiction was not surveyed and was added by NBL

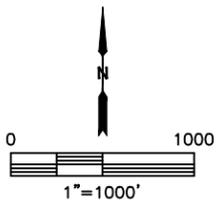

- LEGEND
- = ALIQUOT MONUMENT AS DESCRIBED
 - = CALCULATED POSITION
 - = SURFACE HOLE LOCATION (SHL)
 - ▲ = ENTRY POINT LOCATION (EP)
 - _{BH} = BOTTOM HOLE LOCATION (BHL)
 - ⊙ = EXISTING WELL
 - ⊙ = ABANDONED WELL

CLIENT: NOBLE ENERGY, INC.				LANDMAN: CORY NEIGHBORS					
INSTRUMENT OPERATOR: JAKE STILLE				SURVEY DATE: 11/06/2017		SURFACE USE: RANGELAND			
SHL FOOTAGE	SHL LAT°	SHL LONG°	SHL PDOP	SHL ELEV (FT.)	SHL 1/4/1/4	SHL S-T-R			
300	FNL	2275	FWL	40.43488	-104.46204	3.0	4685	NENW	5-5-63

BHL FOOTAGE	BHL LAT°	BHL LONG°	BHL S-T-R			
0	FNL	2240	FEL	40.46479	-104.45882	29-6-63

NOTE:

- Bearings shown are Grid Bearings of the Colorado State Plane Coordinate System, North Zone, North American Datum 1983. The lineal dimensions as contained herein are based upon the "U.S. Survey Foot."
- Distances to section lines measured at 90 degrees from said section lines.
- Ground elevations are based on an observed GPS elevation (NAVD 1988 DATUM).
- Latitude and Longitude shown are (NAD 83 DATUM).
- IMPROVEMENTS: See LOCATION DRAWING for all visible improvements within 500' of oil and gas location.
- This map does not represent a boundary survey.






WELL LOCATION CERTIFICATE

WELLS RANCH STATE AA32-745

SECTION: 5
TOWNSHIP: 5N
RANGE: 63W
6TH. P.M.
WELD COUNTY, CO

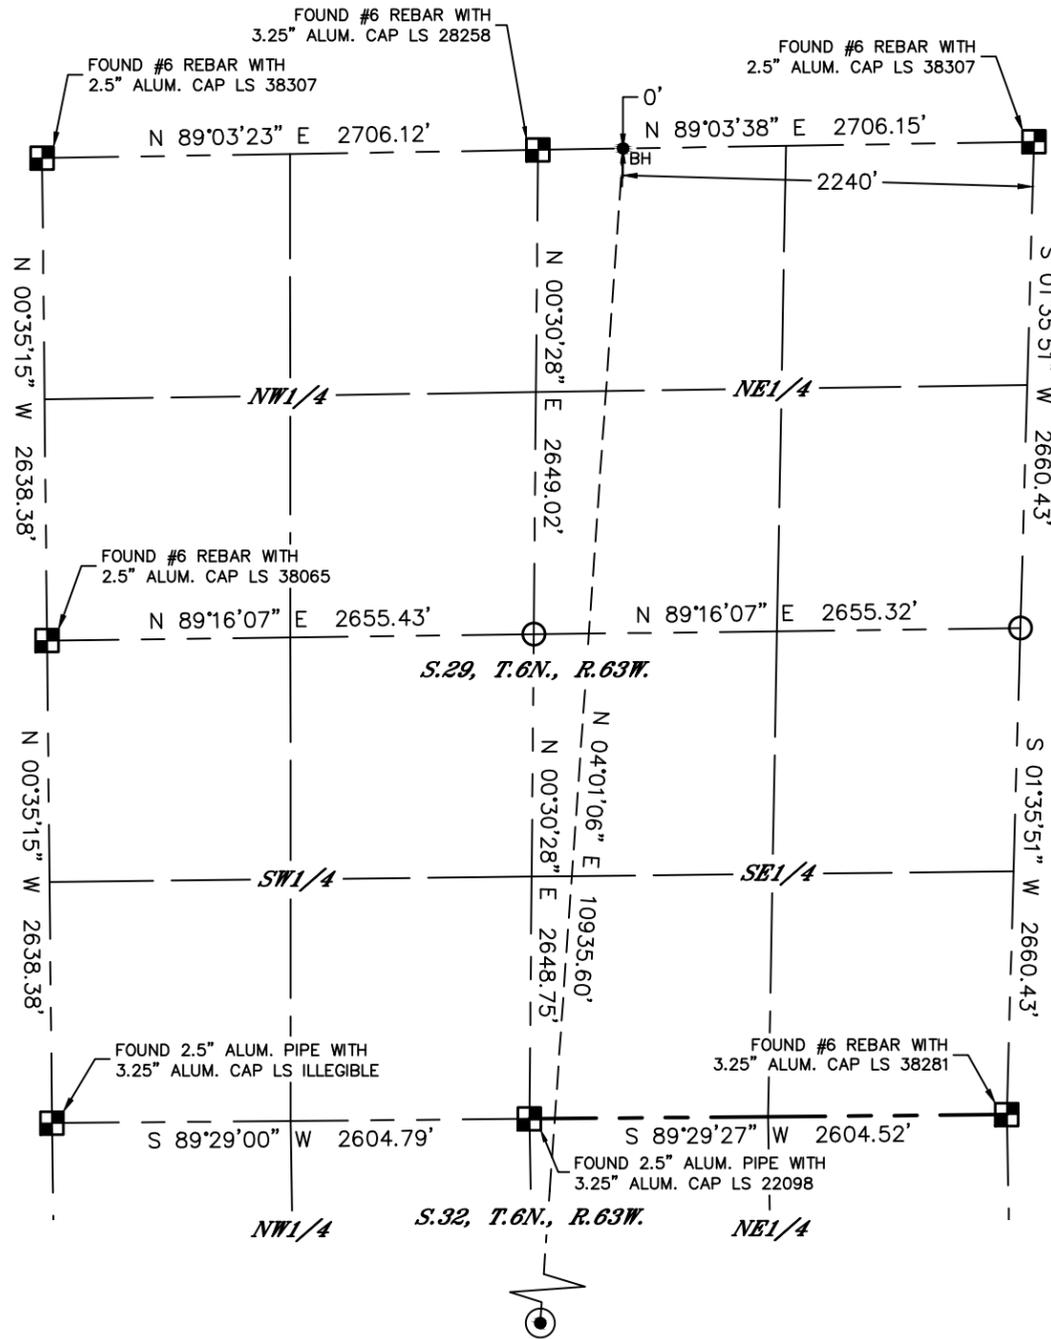

- LEGEND
- = ALIQUOT MONUMENT AS DESCRIBED
 - = CALCULATED POSITION
 - ⊙ = SURFACE HOLE LOCATION (SHL)
 - ▲ = ENTRY POINT LOCATION (EP)
 - = BOTTOM HOLE LOCATION (BHL)
 - ⊕ = EXISTING WELL
 - ⊖ = ABANDONED WELL

