


**PROPOSED WBD**

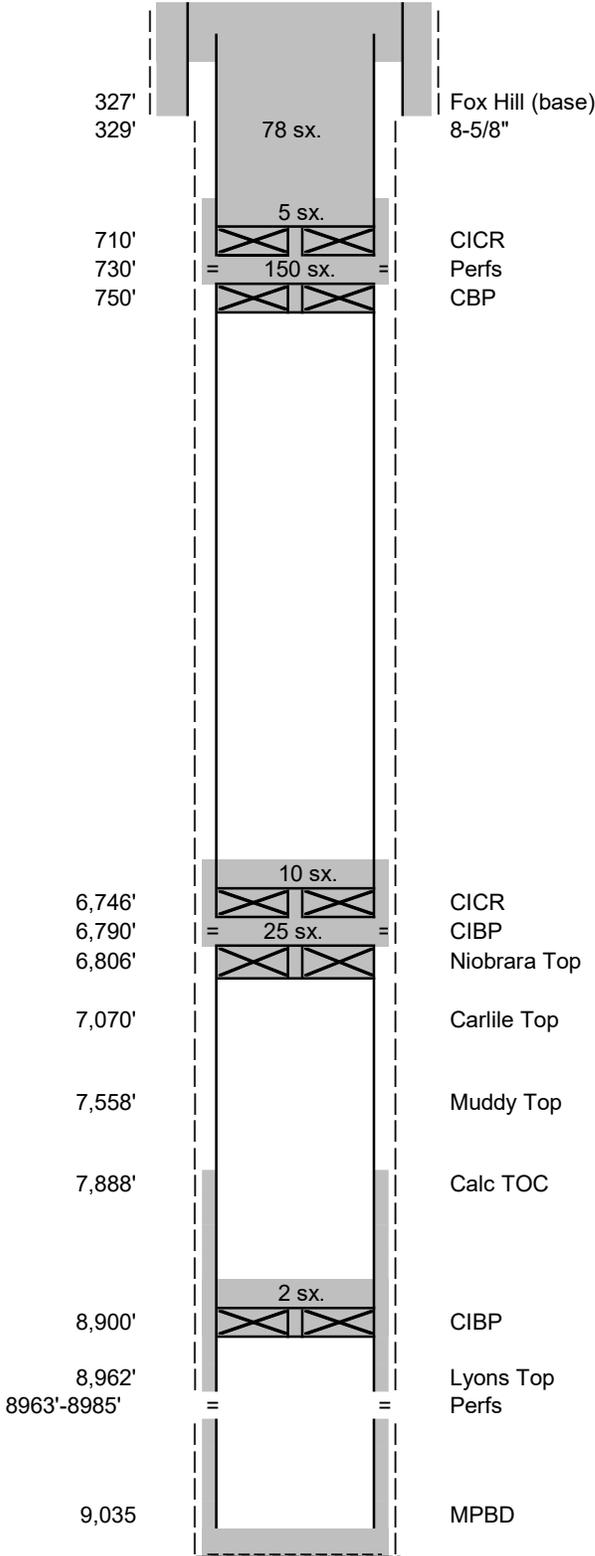

**Enerplus Resources**

WELL: **Colorado State #3** FIELD: Black Hollow

LOCATION: SENE Sec 36-T8N-R67W, Weld Co, CO  
1980' FNL - 660' FWL

ACCTG CODE: STATUS: PA

ELEVATION: GL - 5,127' API NO 05-123-05472

SPUD DATE: 8/10/1955 COMP DATE: 6/26/1973

MEASURED TD: 9,035' TVD: 9,035'

SURF CSG: 9-5/8" 36# set at 329'.  
Cmtd with 225 sks.

PROD CSG: 5-1/2" 15.5/17# set at 9035'  
Cmtd with 300 sks

FORMATION: DEPTH:

Fox Hills	327'	base	***Deepest water well 680'
Niobrara	6,766'	top	
Carlile	7,070'	top	
Muddy	7,558'	top	
Lyons	9,035'	top	

Original Completion:  
6 spf  
6,000 gal of crude oil w/ 2400 lbs glass beads

Original PA:  
Set Model N CIBP @ 8,900' w/ 2 sx. Cmt on top  
Filled 5-1/2" csg and 5-1/2" x 9-5/8" annulus w/H<sub>2</sub>O  
Cut of 9-5/8" x 5-1/2" csg 3.5' below ground level  
Place ~10 sx. Cmt plug in top of 5-1/2" csg & ~5 sx. Cmt plug in the top of 9-5/8" x 5-1/2" annulus  
Welded 1/2" steel plate on top of 9-5/8" surface csg.

Actual Re-Entry PA:  
Set CIBP @ 6,806' w/ 2 sks on top  
Perf @ 6,790', Set CICR @ 6,746' Squeeze w/ 25 sks, 10 sks on top.  
Set CIBP @ 750' w/ 5 sks on top  
Perf @ 730', Set CICR @ 710' Squeeze w/ 150 sks, 5 sks on top.  
Plug from 700' to surface w/ ~78 sks.

Prepared by: Chip Eklund 6/5/2019

TD - 9,035'