




Lat40, Inc. 6250 W. 10th Street, Unit 2, Greeley, CO 970-515-5294


# WELL LOCATION CERTIFICATE

HURLEY H35-755

SECTION: 26  
TOWNSHIP: 3N  
RANGE: 65W  
6TH. P.M.  
WELD COUNTY, CO

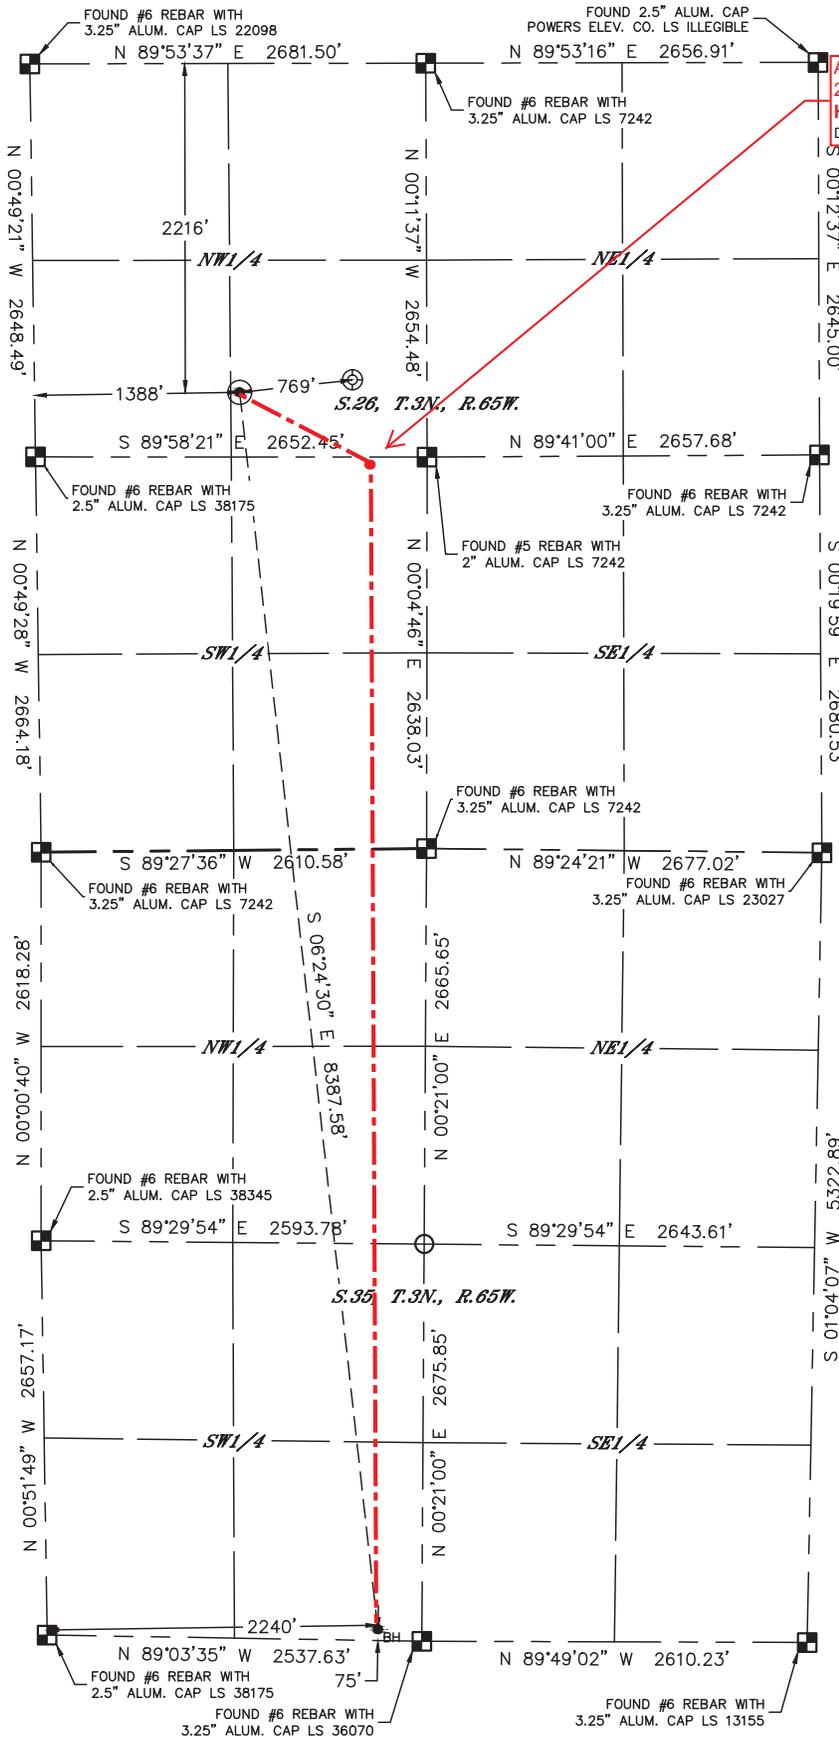

**APPROVED**

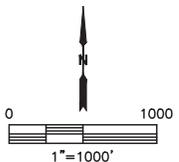


CLIENT: NOBLE ENERGY, INC.			LANDMAN: TYLER BEAVERS						
INSTRUMENT OPERATOR: SCOTT SHERARD			SURVEY DATE: 4/3/2017		SURFACE USE: CROP LAND				
SHL FOOTAGE	SHL LAT°	SHL LONG°	SHL PDOP	SHL ELEV (FT.)	SHL 1/4/1/4	SHL S-T-R			
2216	FNL	1388	FWL	40.19751	-104.63524	1.8	4822	SENW	26-3-65

BHL FOOTAGE	BHL LAT°	BHL LONG°	BHL S-T-R			
75	FSL	2240	FWL	40.17461	-104.63218	35-3-65

- LEGEND
- = ALIQUOT MONUMENT AS DESCRIBED
  - = CALCULATED POSITION
  - = SURFACE HOLE LOCATION (SHL)
  - ▲ = ENTRY POINT LOCATION (EP)
  - = BOTTOM HOLE LOCATION (BHL)
  - ⊙ = EXISTING WELL
  - ⊙ = ABANDONED WELL

NOTE:

- Bearings shown are Grid Bearings of the Colorado State Plane Coordinate System, North Zone, North American Datum 1983. The lineal dimensions as contained herein are based upon the "U.S. Survey Foot."
- Distances to section lines measured at 90 degrees from said section lines.
- Ground elevations are based on an observed GPS elevation (NAVD 1988 DATUM).
- Latitude and Longitude shown are (NAD 83 DATUM).
- IMPROVEMENTS: See LOCATION DRAWING for all visible improvements within 500' of oil and gas location.
- This map does not represent a boundary survey.

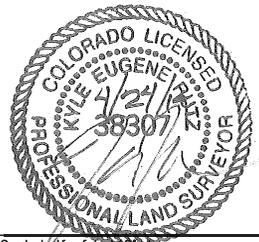

Kyle E. Rutz—On behalf of Lat40, Inc.  
Colorado Licensed Professional Land Surveyor No. 38307  
DATE: 4/24/2019  
PROJECT#: 2017022