

Well/Facility:

Operator:

Lease/Op Agmt:

Field:

County:

State:

Spud:

Comp. Date:

1st Prod:

Xmas tree:

Surface Loc:

Sec-Twn-Rge:

Comments:

Little Beaver Unit #41

Maggie Operating Inc

Little Beaver

Washington

CO

5/19/1953

6/2/1953

6/12/1953

330 FNL 1,650 FEL

NWNE 5 2S56W

Current Well Diagram

Well Status:

Formation:

Prod Interval:

API #:

GR/KB:

TD:

PBTD:

WI:

NRI:

SI

DSND


5,178' - 5,226'

05-121-06222

4,643'

5,289'

5,283'

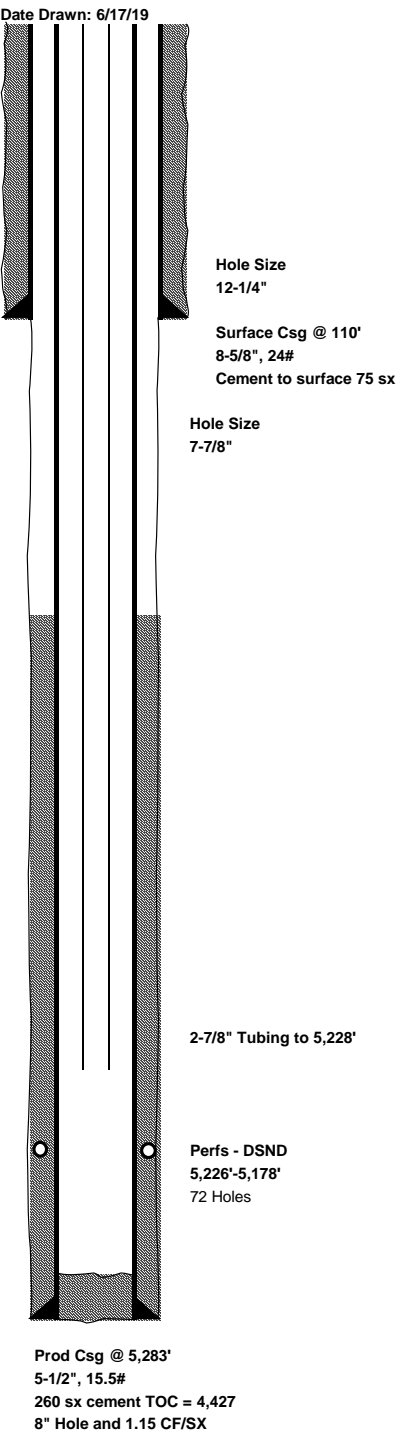

Gologic Markers		
MD		
4,344	Niobrara	
4,789	Carlile	
5,174	D Sand	
5,250	J Sand	