

# McElwain #11-17

Township/Range: 17 001-S

NW NW 17 1S67W 6 PM


Latitude/Longitude: N39.96888900, W -104.91833300:

39.968889/-104.918333

County: Adams, State: CO

Spud Date: 6/10/1998

Total Depth: 8615

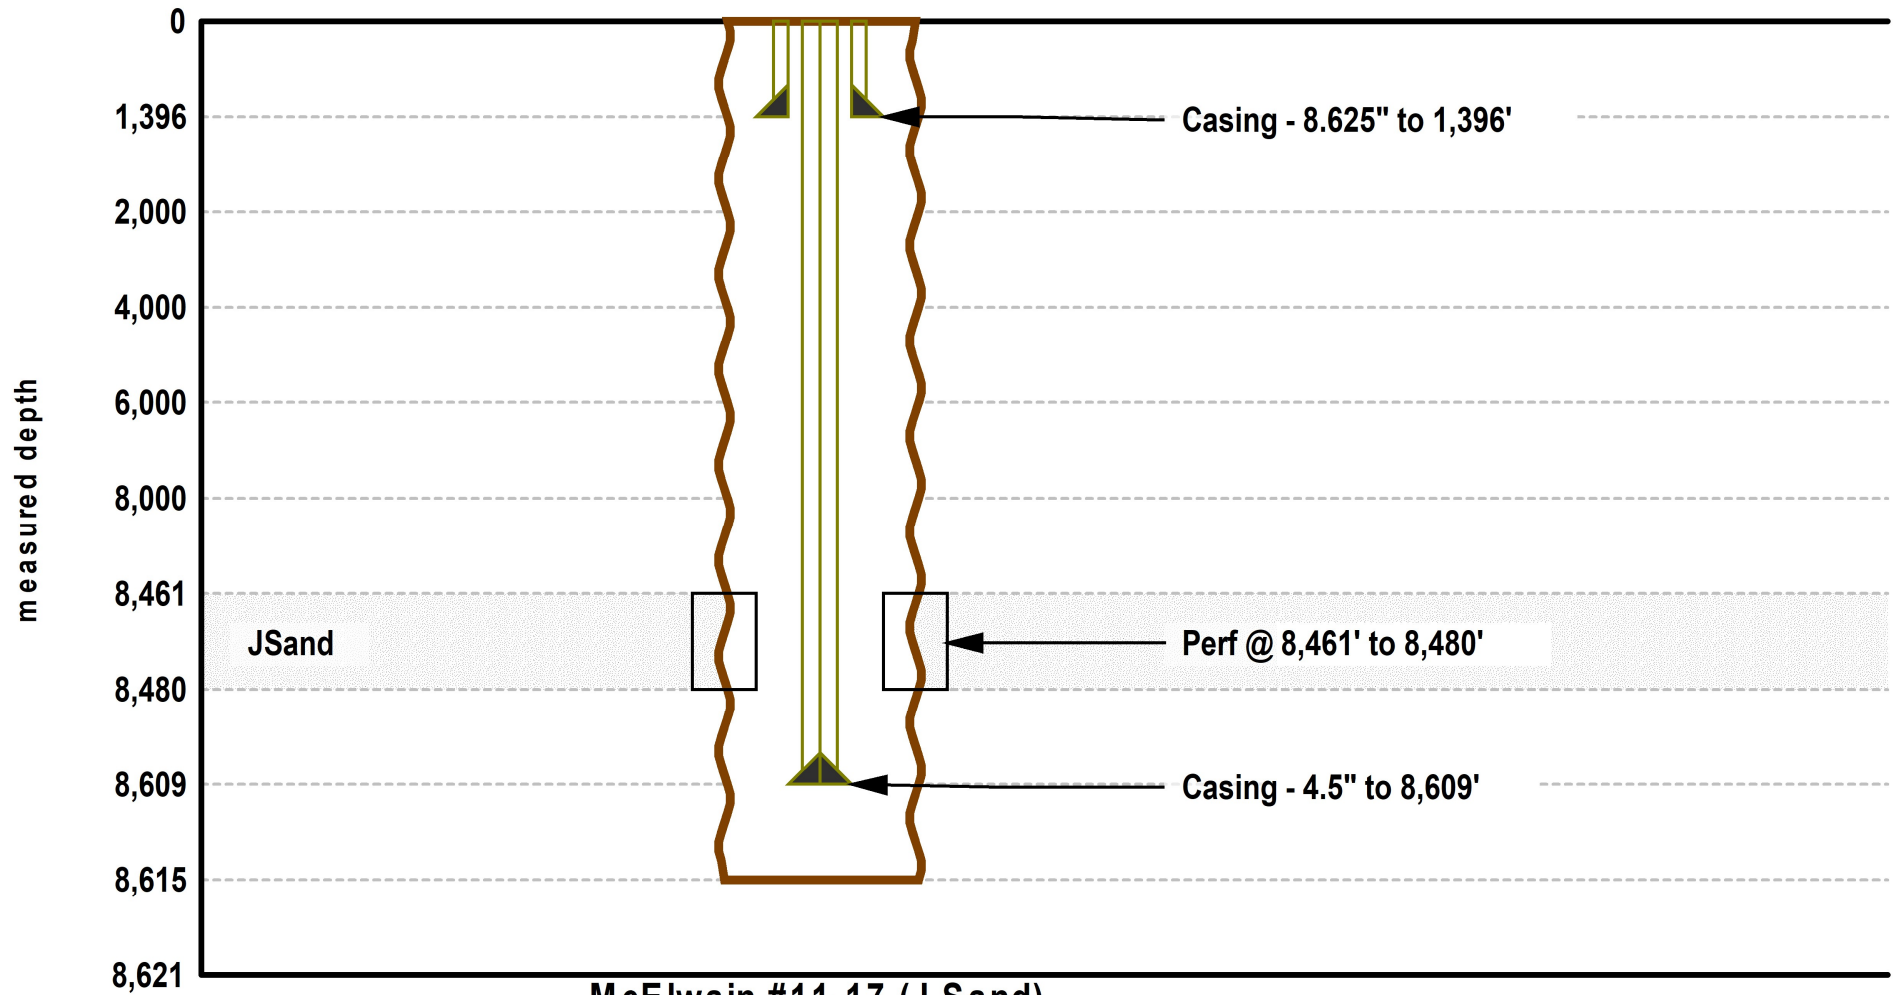

McElwain #11-17 (J Sand)  
Initial Completion: 12/30/1899