




SECTION ~~9~~ 11
T. 34 S., R. 68 W.

67' North
49,264' East
1320'
Colorado Fuel & Iron No. 2
Ground elev. 8635
9.33 mile
1320'
1/4 Mile Past No. 22
Beaubien Miranda Grant

I, Harold Duane Haley, Registered Land Surveyor, State of Colorado, license No. 2184, do hereby certify that this plat shows the true location of Continental Oil Co. oil well in Las Animas County, Colorado. The location was made under my supervision on April 26, 1955, and the plat is made from information on file in this office.

Harold Duane Haley
Registered Land Surveyor

BEST IMAGE
AVAILABLE

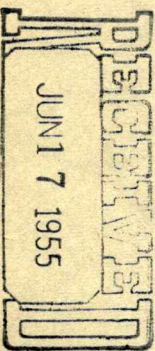

OIL & GAS
CONSERVATION COMMISSION

CONOCO		CONTINENTAL OIL COMPANY		CONOCO	
PRODUCTION DEPARTMENT					
DRAWN	HDH	SCALE	1"=1000'	FILE NO.	
CHECKED		DATE			
APPROVED		SHEET	OF		

LOCATION PLAT OF
COLORADO FUEL & IRON No. 2