


## APPLICATION RULES

Fee and Fed Lands: 100' from drlg unit, no setback from exterior boundary (unless adjoining lands are not 10-Acre approved)

**Setbacks same on Fee and Fed lands**

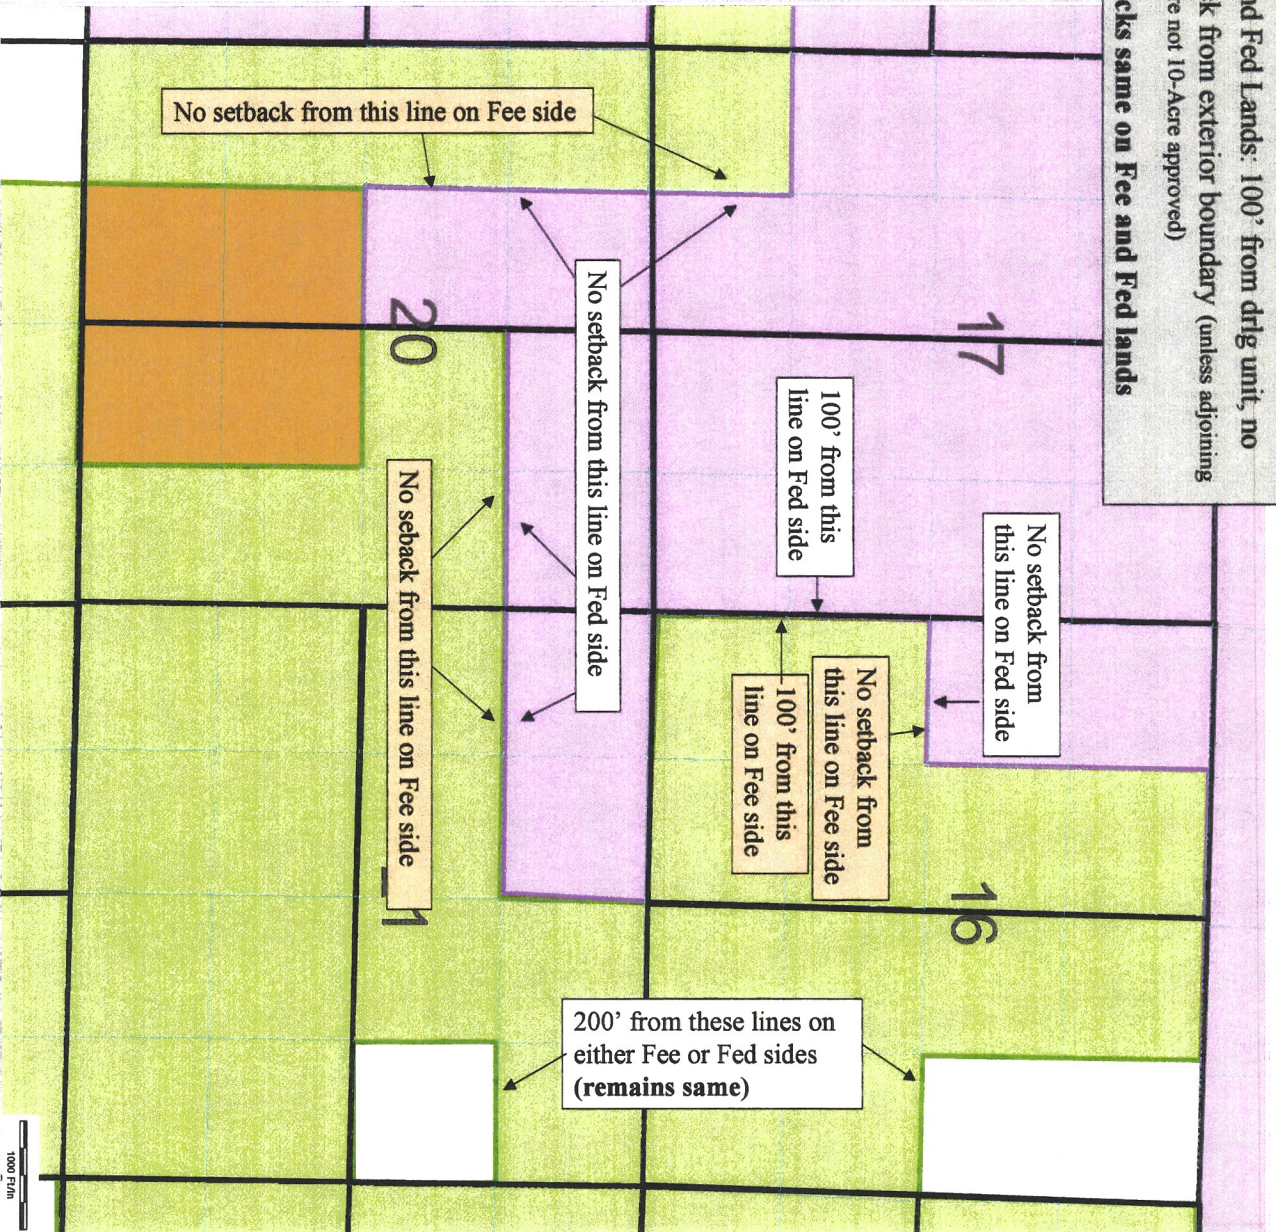

01155858