




00271737

RECEIVED

JAN - 5 1967

R. 68W COLO. OIL & GAS CONS. COMM.

JAN 8 1967

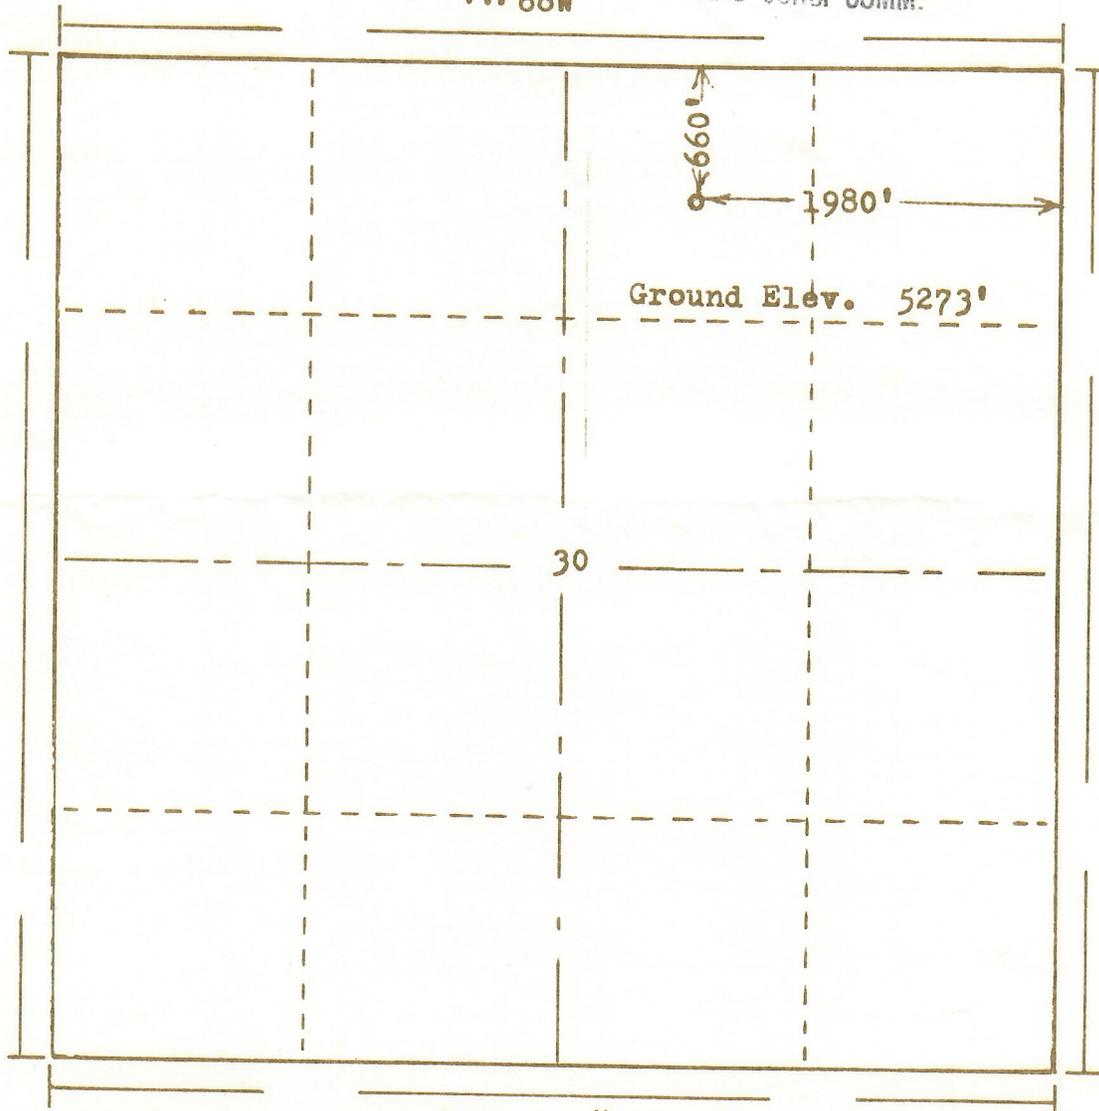

T. 9 N

Scale ... 1" = 1000'

Powers Surveyors, Inc. of Denver, Colorado
 has in accordance with a request from Florence Johnston
 for Stuarco Oil Co., Inc. determined the
 Location of No.1 Bremer
 to be CNW NE Section 30 Township 9N
 Range 68W of the 6th Principal Meridian
 Larimer County, Colorado

I hereby certify that this plat is an
 accurate representation of a correct
 survey showing the location of

Date: 12-27-66

Brian J. Holloman
 Licensed Land Surveyor No. 2853
 State of Colorado